

LAND CORNER RECORDATION CERTIFICATE
Filing Requirement of Act 74, Mich P.A. 1970

STATE OF MICHIGAN
ROSCOMMON COUNTY
RECORDED

For corners in
Roscommon County

19 MAY 98 11:08 A.M.

ROBERT W. SMITH
REGISTER OF DEEDS

	Located in:	Corner Code #
1. Public Land Survey	T22N R.3W	B-13
	T21N R3W	B-1 ✓
	T R	
	T R	

FILE IN LIBER 3 OF LAND CORNERS
Register of Deeds Stamp & File Number

I, Larry L. Cavanagh, in a field survey April, 1998, do hereby certify that under requirements of P.A. 74, Michigan P.A. of 1970, the corner points mentioned in line 1 above was in conformance with regulations and rules therefore as required in the current manual of survey instructions of the United States Department of the Interior, Bureau of Land Management or by a decree of a Court of Law; established, re-established, monumented, recovered, found as expressed below:

	A	B	C	D	E	F	G	H	I	J	K	L	M
2	6	5	4	3	2	1							
3													
4	7	8	9	10	11	12							
5													
6	18	17	16	15	14	13							
7													
8	19	20	21	22	23	24							
9													
10	30	29	28	27	26	25							
11													
12	31	32	33	34	35	36							
13													

A. Description of original monument and accessories and/or subsequent restoration:

JOHN BRINK 1838 WIT: YELLOW PINE 14" DIAMETER 1/4 SECTION CORNER	JAMES RICHARDSON 1937 RE-ESTABLISHED COR.-BAR NBT-Y. PINE S. 14, S14 1/2"E 14.6 Y. PINE S. 24, S46 1/2"W 34.6
DNR 1930'S NO BEARING TREES	

B. Description of corner evidence found and/or method applied in restoring or reestablishing corner:

FOUND 1/2" BAR. FITS SECTION SUBDIVISION IN SECTION 31

C. Description of monument for corner and accessories established to perpetuate locating the position of the corner:

SET STANDARD ROSCOMMON COUNTY MONUMENT STAMPED 17614
WIT: NAIL & TAG IN 12" BALSAM N40°E 22.85'
NAIL & TAG IN 14" OAK N73°W 50.45'
NAIL & TAG IN 7" BALSAM S60°W 41.80'
NAIL & TAG IN 8" SPRUCE S55°E 22.98'
CARSONITE POST NORTH 16.0'

THE BEST AVAILABLE EVIDENCE OF THE POSITION OF THE ORIGINAL CORNER.

SURVEY &
REMONUMENTATION

OCT 05 1998

SECTION


ROSCOMMON COUNTY
PEER GROUP APPROVAL

DATE May 16 1998
Marvin E. Myers

Marvin E. Myers, P.S.
County Surveyor

Signed by Larry L. Cavanagh
Surveyor's Michigan License NO. 17614

Date May 16 1998

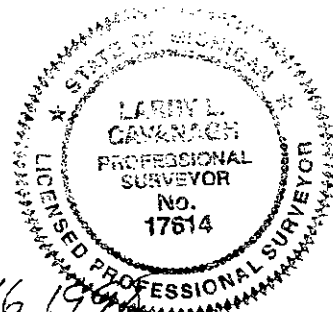

FORM APPROVED BY MICHIGAN STATE BOARD OF LAND SURVEYORS, JAN 28, 1971
REVISED MAY 14, 1975
REVISED JAN., 1983