

3901

LAND CORNER RECORDATION CERTIFICATE
Filing Requirement of Act 74, Mich P.A. 1970

STATE OF MICHIGAN
ROSCOMMON COUNTY
RECORDED

19 MAY 98 11:10 A.M.

ROBERT W. SMITH
REGISTER OF DEEDS

For corners in
Roscommon County

Located in: Corner Code #

1. Public Land Survey

T22N R3W K-13
T21N R3W K-1 ✓
T R
T R

FILE IN LIBER 3 OF LAND CORNERS

Register of Deeds Stamp & File Number

I, Larry L. Cavanagh, in a field survey April, 1998, do hereby certify that under requirements of P.A. 74, Michigan P.A. of 1970, the corner points mentioned in line 1 above was in conformance with regulations and rules therefore as required in the current manual of survey instructions of the United States Department of the Interior, Bureau of Land Management or by a decree of a Court of Law; established, re-established, monumented, recovered, found as expressed below:

	A	B	C	D	E	F	G	H	I	J	K	L	M
2	6	5	4	3	2	1							
3													
4	7	8	9	10	11	12							
5													
6	18	17	16	15	14	13							
7													
8	19	20	21	22	23	24							
9													
10	30	29	28	27	26	25							
11													
12	31	32	33	34	35	36							
13													

A. Description of original monument and accessories and/or subsequent restoration

JOHN BRINK 1838 DNR 1930'S
SET POST FOUND U.S. BEARINGS
PITCH PINE 10 N69E 26 NO TREES FOR N.B.T.
PITCH PINE 10 N12W 36

WILLIAM A. BURT 1850 LCRC, 1970'S, L2, P250
S. PINE 10 S29W 18 2" PIPE
S. PINE 9 SSE 13 8" B. OAK S3W 23.5'
20" B. OAK N65E 30.35'

SCHAAF INDICATES STAKE LARRY L. CAVANAGH 1974
SET IN PREPARATION FOR SECTION SUB-DIVISION SURVEY
IRON FD 2" PIPE
SAME WITNESSES AS ABOVE

B. Description of corner evidence found and/or method applied in restoring or reestablishing corner:

FOUND 2" PIPE 8" X 8" X 8" CONCRETE BASE
BOTH 1970'S WITNESSES

C. Description of monument for corner and accessories established to perpetuate locating the position of the corner:

SET STANDARD ROSCOMMON COUNTY MONUMENT STAMPED 17614
WIT: NAIL & TAG IN 11" NORWAY S57°E 80.10'
NAIL & TAG IN 26" NORWAY N71°E 54.89'
NAIL & TAG IN 24" STUMP N65°E 30.35'
NAIL & TAG IN 4" B. OAK N42°W 43.51'
NAIL & TAG IN 10" STUMP S7°W 23.5'
CARSONITE POST N60°E 29.7'

A PERPETUATION OF THE ORIGINAL GOVERNMENT CORNER.


SURVEY &
REMONUMENTATION

OCT 05 1998

SECTION

ROSCOMMON COUNTY
PEER GROUP APPROVAL
DATE MAY 15 1998

Marvin E. Myers
Marvin E. Myers, P.S.
County Surveyor

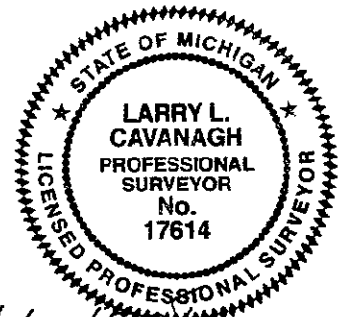

Signed by *Larry L. Cavanagh* Date MAY 16, 1998
Surveyor's Michigan License NO. 17614

FORM APPROVED BY MICHIGAN STATE BOARD OF LAND SURVEYORS, JAN 28, 1971
REVISED MAY 14, 1975
REVISED JAN., 1983