

# LAND CORNER RECORDATION CERTIFICATE

## Filing Requirement of Act 74, Mich. PA 1970

For Corners In: \_\_\_\_\_ Located In \_\_\_\_\_ Corner Code # \_\_\_\_\_  
 Roscommon \_\_\_\_\_  
 (County) \_\_\_\_\_

1. Public Land Survey T 21N R 3W E13  
T \_\_\_\_\_ R \_\_\_\_\_
2. Property Controlling in Section S \_\_\_\_\_ T \_\_\_\_\_ R \_\_\_\_\_  
S \_\_\_\_\_ T \_\_\_\_\_ R \_\_\_\_\_
3. Miscellaneous Property in Section S \_\_\_\_\_ T \_\_\_\_\_ R \_\_\_\_\_  
S \_\_\_\_\_ T \_\_\_\_\_ R \_\_\_\_\_

4. Lot No: \_\_\_\_\_ Recorded Plat: \_\_\_\_\_  
 5. Private Claims: \_\_\_\_\_

1. Craig W. McVean, in a field survey on Sept. 12, 2002 do hereby state that under requirements of PA 74, Michigan PA of 1970, the corner points mentioned in lines 1 and 2 above were in conformance with regulations and rules therefore as required in the current manual of survey instructions of the United States Department of the Interior, Bureau of Land Management or by a decree of a Court of Law and/or that the corner points mentioned in lines 3, 4 and 5 above were in conformance with the rules of the Michigan Board of Land Surveyors or by a Decree of a Court of Law; established, re-established, monumented, recovered, found as expressed below:

**NOTE: Not more than 2 corners, all in the same town and range, may be recorded on this certificate.**

	A	B	C	D	E	F	G	H	I	J	K	L	M
1													
2	6	5	4	3	2	1							
3													
4	7	8	9	10	11	12							
5													
6	18	17	16	15	14	13							
7													
8	19	20	21	22	23	24							
9													
10	30	29	28	27	26	25							
11													
12	31	32	33	34	35	36							
13													

Register of Deeds Stamp & File Number

A. Description of original monument and accessories and/or subsequent restoration:


- E13 – GLO – Set Post – J. Brink – 1837  
 Pitch Pine 11" N9°W 18 L.  
 Pitch Pine 12" N41°E 41L.  
 - Belknap – No Date – Established Corner NBT. W Pine Stub 24" N30°31'W 224½"  
 - M. Schaaf – 1921 – JP NE & hole for NW BT in place  
 - K.J. Ostling – 1966 – Set 1" pipe with 4" Aluminum Cap on line over ¼ and section corner east at double distance from ¼ corner. This falls at probable position of previous
- Schaaf corner, although any previous corner was removed during road construction or planting. Evidence of pits NE and SW 50 Links. 8" R. Pine N42°E 33.1'.  
 Unrec. Sur. – North Central Survey – Proj. #78350 – 1979 – L. Cavanagh – Fd. Iron with DNR Cap.  
 8" R. Pine N42°E 33.1'; N&T in North Face 3" R. Pine S60°E 19.35'; N&T in South Face 6" Poplar S35°E 20.00'; N&T in East Face 3" R. Pine S10°E 20.84'

B. Description of corner evidence found and/or method applied in restoring or re-establishing corner:

- E13 – Standard Sec. Cor. Common to Sec. 32 & 33, T21N, R3W – Fd. Broken 4" DOC (DNR) Aluminum Cap on 1" Iron Pipe per Ostling. Centerline of E-W 2-Track is 7' North.  
 DOC Mon. accepted as a careful and faithful perpetuation of the position of the original corner.

C. Description of monument for corner and accessories established to perpetuate locating the position of the corner:

- E13 – Replaced broken DOC Alum. Cap with 4" DNR Alum. Cap on existing 1" Iron pipe.  
 East 1' to set Blue Carsonite Post.  
 N42°E 33.35' to Set N&T in SE Side 21" R. Pine (KJO, LC)  
 S48°W 18.35' to Set N&T in SE Side 6" W. Pine scribed 'XBT'  
 N35°W 36.15' to Set N&T in NE Side 7" W. Pine scribed 'XBT'  
 S26°E 24.22' to Set N&T in NE Side 9" R. Pine scribed 'XBT'  
 S89° 29'55"E 690.67' (Grid Dist.) (690.36' – GLO) to E1, T20N, R3W

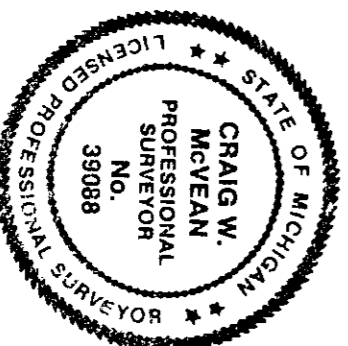

Signed by: Craig W. McVean  
 Surveyor's Michigan License No.: 39088

Date: 12/3/2003