LAND CORNER RECORDATION CERTIFICATE

Filing Requirement of Act 74, Mich. P.A. 1970

For corners in
ROSCOMMON
(County)

	Located In:	Corner Code ##
1. Public Land Survey	T 21N R 4W	F-13
	T ___ R ___	G-13
	T ___ R ___	
	T ___ R ___	
2. Property Controlling	S ___ T ___ R ___	
in Section	S ___ T ___ R ___	
3. Miscellaneous	S ___ T ___ R ___	
Property in Sec.	S ___ T ___ R ___	

Register of Deeds Stamp & File Number

4. Lot No. _____ , Recorded Plat _____
5. Private Claims _____

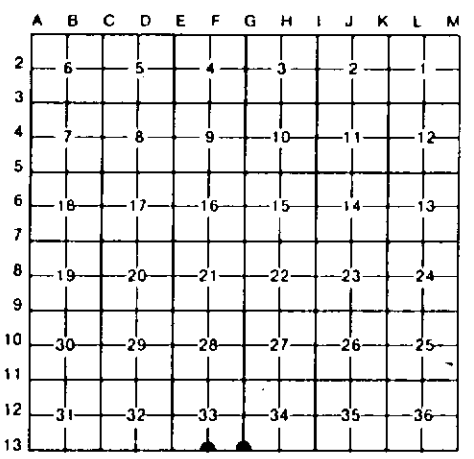

I, CARL F. ROSER, in a field survey on JUNE 20, 19 88, do hereby certify that under requirements of P.A. 74, Michigan P.A. of 1970, the corner points mentioned in lines 1 and 2 above were in conformance with regulations and rules therefore as required in the current manual of survey instructions of the United States Department of the Interior, Bureau of Land Management or by a decree of a Court of Law and/or that the corner points mentioned in lines 3, 4 and 5 above were in conformance with the rules of the Michigan Board of Land Surveyors or by a Decree of a Court of Law; established, re-established, monumented, re-monumented, recovered, found as expressed below:

NOTE: Not more than 4 corners, all in the same town and range, may be recorded on this certificate.

A. Description of original monument and accessories and/or subsequent restoration:

F-13

G-13

G-13 CONT.

B. Description of corner evidence found and/or method applied in restoring or reestablishing corner:

F-13

ACCEPTED OLD PIPE FOR S 1/4 S-33. WAS PROBABLY SET BY MARCUS SCHAAF, CONS. DEPT SURVEYOR/FORESTER, IN 1930'S. COR FITS 3 MSHD 1958± WITS (MATT KOIVISTO, SURVEY CHIEF). SCHAAF NOTES (PENCIL ADDITIONS TO 1936 CONS DEPT LEATHER BOOK OF GLO LINE NOTES, T20N-R4W) SAY "TAMARACK NE STUB STANDS WITH SCRIBED 1/4 PLAIN".

G-13

MATT KOIVISTO, SUR CHIEF, MSHD, FD 4" X 4" WOOD STK; RAISED W/2" PIPE (IN 1958). STK IS EITHER BY H.BELKNAP (1911) WHO HAD USBT'S OR M.SCHAAF (1930'S) WHO SAYS "SET BY PROP MEA" (SEE CONS. DEPT LEATHER BOUND BOOK OF GLO LINE NOTES, 1936, T20N-R4W, W/PENCIL ADDITIONS BY M.SCHAAF). FD 2" PIPE FITS 2-MSHD NBT'S. DEPT SURVEYOR,

G-13 CONT.

KEN OSTLING, TIED INTO THIS 2" PIPE IN 1966.

C. Description of monument for corner and accessories established to perpetuate locating the position of the corner:

F-13

FD 2" X 4' RUSTY PIPE. DROVE 1" X 8' GALV PIPE W/STD DNR CAP; SET CED POST.

* 5" B SPRUCE	N15°W	12.46'
5" B SPRUCE	N40°E	15.72'
12"OLD PINE STP	S70°E	14.9'
* 6" B SPRUCE	S60°E	20.92'

N 1/4 COR S-4
T20N-R4W S89°58'E 445.95'
*EQUALS MSHD WITS.

G-13

FD 2" PIPE; DROVE 1" X 8' GALV PIPE W/DNR CAP INSIDE; SET CED POST W/LOC TAG.

8" TAMARACK	N10°W	57.0'
5" TAMARACK	S23°E	54.0'
4" TAMARACK	S75°W	16.5'

SW'LY EDGE
TAMARACK SWP DUE N 315'±10'
E'LY EDGE
TAMARACK SWP DUE E 225'±10'

G-13 CONT.

NE COR S-4
T20N-R4W IS S89°58'E 450.09'

Signed by Carl F. Roser 01-11-90 Date

Surveyor's Michigan License No. 12028

STATE OF MICHIGAN
CARL F. ROSER
LAND SURVEYOR
No. 12023
REGISTERED LAND SURVEYOR

FORM APPROVED BY MICHIGAN STATE BOARD OF LAND SURVEYORS 1971
REVISED MAY, 1975
REVISED JAN., 1983