

SURVEY & REMONUMENTATION

APR 34 1995

COMMISSION

ROSCOMMON COUNTY REMONUMENTATION

LAND CORNER RECORDATION CERTIFICATE

Filing Requirement of Act 74, Mich. P.A. 1970

For corners in
Roscommon

(County)

Located In:

Corner Code #

- | | | | | | |
|------------------------------------|---|-----|---|----|------|
| 1. Public Land Survey | T | 21N | R | 2W | M-10 |
| | T | | R | | |
| | T | | R | | |
| | T | | R | | |
| 2. Property Controlling in Section | S | | T | R | |
| | S | | T | R | |
| 3. Miscellaneous Property in Sec. | S | | T | R | |
| | S | | T | R | |
4. Lot No. _____, Recorded Plat _____
5. Private Claims _____

TO BE FILED IN LIBER 3 OF LAND CORNER
Register of Deeds Stamp & File Number

Timothy L. Lapham in a field survey on June 94

do hereby certify that under requirements of P.A. 74, Michigan P.A. of 1970, the corner points mentioned in lines 1 and 2 above were in conformance with regulations and rules therefore as required in the current manual of survey instructions of the United States Department of the Interior, Bureau of Land Management or by a decree of a Court of Law and/or that the corner points mentioned in lines 3, 4 and 5 above were in conformance with the rules of the Michigan Board of Land Surveyors or by a Decree of a Court of Law; established, re-established, monumented, re-monumented, recovered, found as expressed below.

NOTE: Not more than 4 corners, all in the same town and range, may be recorded on this certificate.

	A	B	C	D	E	F	G	H	I	J	K	L	M
2	6	5	4	3	2	1							
3													
4	7	8	9	10	11	12							
5													
6	18	17	16	15	14	13							
7													
8	19	20	21	22	23	24							
9													
10	30	29	28	27	26	25							
11													
12	31	32	33	34	35	36							
13													

A. Description of original monument and accessories and/or subsequent restoration:

- M-10: 1837, BRINK, POST, BEECH 11" S4 1/2W 28LKS, BEECH 8" N46W 23LKS;
1990, CAVANAGH, SURVEY 572-549 to 554, COR MAT, 4 WITS;
5/5/1990, CAVANAGH, SURVEY 572-555, COR MAT, 4 WITS;
5/5/1990, CAVANAGH, SURVEY 572-556, COR MAT 4 WITS;
6/5/1990, CAVANAGH, LCRC 1-281, COR MAT 4 WITS;


B. Description of corner evidence found and/or method applied in restoring or reestablishing corner:

- M-10: FOUND 1/2" X 18" CAPPED STEEL BAR, EXCAVATED TO 3 FEET AND FOUND NO FURTHER EVIDENCE
FOUND ACCESSORIES
N55W 33.63' 5" MAPLE
S56W 39.0' SPIKE IN FENCE POST
S59E 56.74' 10" S. PINE
N72E 52.2' 14" S. PINE
ACCEPTED FOUND CORNER AS BEST AVAILABLE EVIDENCE OF THE LOCATION OF THE ORIGINAL CORNER.
THIS CORNER ESTABLISHED IN ACCORDENCE WITH THE ROSCOMMON REMONUMENTATION PROGRAM. SEE DOSSIER FOR DETAILED REPORT.

C. Description of monument for corner and accessories established to perpetuate locating the position of the corner:

- M-10: SET A 2 1/2" x 24" CAST IRON MONUMENT 4" BELOW SURFACE OF ASPHALT IN A MONUMENT BOX WITH BRASS DISK MARKED "ROSCOMMON COUNTY, 1994 27595"
N55W 33.90' SPIKE & TAG IN 5" MAPLE
S56W 39.0' SPIKE & TAG IN FENCE POST
S59E 57.30' SPIKE & TAG IN 10" S. PINE
N72E 52.65' SPIKE & TAG IN 14" S. PINE
CORNER FALLS IN EXISTING ROAD CENTERLINE

ROSCOMMON COUNTY
PEER GROUP APPROVAL
DATE 7-29-94

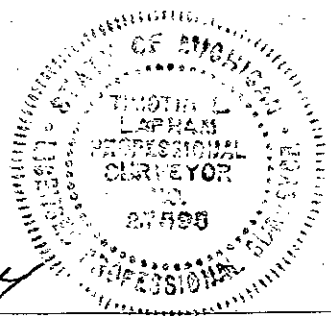

Signed by

[Signature]

Date

9/26/94

Surveyor's Michigan License No. 27595

FORM APPROVED BY MICHIGAN STATE BOARD OF LAND SURVEYORS, JAN. 28, 1971
REVISED MAY 14, 1975
REVISED JAN., 1983

LIBER 3 PAGE 94