

SURVEY & REMONUMENTATION

7136

APR 24 1995

ROSCOMMON COUNTY REMONUMENTATION

COMMISSION AND CORNER RECORDATION CERTIFICATE Filing Requirement of Act 74, Mich. P.A. 1970

RECEIVED
SEP 21 1994

For corners in

ROSCOMMON	Located In:	Corner Code #
(County)		
1. Public Land Survey	T <u>21N</u> R <u>2W</u>	<u>M-12</u>
	T _____ R _____	_____
	T _____ R _____	_____
	T _____ R _____	_____
2. Property Controlling in Section	S _____ T _____ R _____	_____
	S _____ T _____ R _____	_____
3. Miscellaneous Property in Sec.	S _____ T _____ R _____	_____
	S _____ T _____ R _____	_____

TO BE FILED IN LIBER 3 OF LAND CORNER
Register of Deeds Stamp & File Number

4. Lot No. _____, Recorded Plat _____
5. Private Claims _____

Timothy L. Lapham in a field survey on June, 1994, do hereby certify that under requirements of P.A. 74, Michigan P.A. of 1970, the corner points mentioned in lines 1 and 2 above were in conformance with regulations and rules therefore as required in the current manual of survey instructions of the United States Department of the Interior, Bureau of Land Management or by a decree of a Court of Law and/or that the corner points mentioned in lines 3, 4 and 5 above were in conformance with the rules of the Michigan Board of Land Surveyors or by a Decree of a Court of Law, established, re-established, monumented, re-monumented, recovered, found as expressed below:

	A	B	C	D	E	F	G	H	I	J	K	L	M
2	6		5		4		3		2		1		
3													
4	7		8		9		10		11		12		
5													
6	18		17		16		15		14		13		
7													
8	19		20		21		22		23		24		
9													
10	30		29		28		27		26		25		
11													
12	31		32		33		34		35		36		
13													

NOTE: Not more than 4 corners, all in the same town and range, may be recorded on this certificate.

A. Description of original monument and accessories and/or subsequent restoration:


M-12: 1837, BRINK, POST, BEECH 10" N4 1/2W 29LKS, BEECH 7" S23 1/2W 21LKS;
1990, CAVANAGH, SURVEY 572-549 TO 554, COR MAT, 5 WITS;
6/5/1990, CAVANAGH, LCRC 1-281, COR MAT, 5 WITS;

B. Description of corner evidence found and/or method applied in restoring or reestablishing corner:

M-12: FOUND 1/2" X 18" CAPPED STEEL BAR, EXCAVATED TO 3 FEET AND FOUND NO FURTHER EVIDENCE;
FOUND ACCESSORIES
NORTH 4' FENCE LINE WEST
S52W 61.7' 6" ASH
S63E 66.07' 2" S.PINE
N58E 64.92' P.POLE
ACCEPTED FOUND CORNER AS BEST AVAILABLE EVIDENCE OF THE LOCATION OF THE ORIGINAL CORNER.
THIS CORNER ESTABLISHED IN ACCORDENCE WITH THE ROSCOMMON REMONUMENTATION PROGRAM. SEE DOSSIER FOR DETAILED REPORT.

C. Description of monument for corner and accessories established to perpetuate locating the position of the corner:

M-12: SET A 2 1/2" x 24" CAST IRON MONUMENT 4" BELOW SURFACE OF ASPHALT IN A MONUMENT BOX WITH BRASS DISK MARKED "ROSCOMMON COUNTY, 1994 27595"
NORTH 4' FENCE LINE WEST
S52W 62.04' SPIKE & TAG IN 8" ASH
S63E 65.07' SPIKE & TAG IN 4" S. PINE
N58E 66.10' SPIKE & TAG IN P. POLE
N30W 85.12' SPIKE & TAG IN 6"X 6"X 10' CORNER FENCE POST
CORNER FALLS IN EXISTING ROAD CENTERLINE

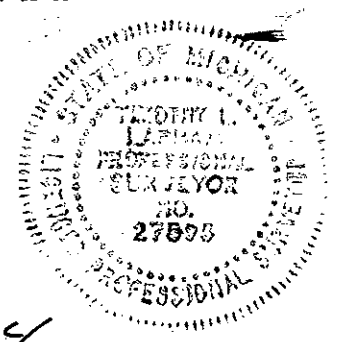

**ROSCOMMON COUNTY
PEER GROUP APPROVAL
DATE 7-29-94**

Signed by [Signature]

Date 9/26/94

Surveyor's Michigan License No. 27595

LIBER 3 PAGE 96