

**LAND CORNER RECORDATION CERTIFICATE**  
**Filing Requirement of Act 74, Mich. P.A. 1970**

For corners in

<u>Roscommon</u> (County)	Located In:	Corner Code #
1. Public Land Survey	T 22N R 1W	E-2
	T 22N R 1W	E-1
	T _____ R _____	_____
	T _____ R _____	_____
2. Property Controlling in Section	S 4 T 22N R 1W	3
	S 4 T 22N R 1W	10
3. Miscellaneous Property in Sec.	S _____ T _____ R _____	_____
	S _____ T _____ R _____	_____

Register of Deeds Stamp & File Number

4. Lot No. \_\_\_\_\_, Recorded Plat \_\_\_\_\_  
 5. Private Claims \_\_\_\_\_

I, Carl R. Johnson, in a field survey on January 8, 19 87, do hereby certify that under requirements of P.A. 74, Michigan P.A. of 1970, the corner points mentioned in lines 1 and 2 above were in conformance with regulations and rules therefore as required in the current manual of survey instructions of the United States Department of the Interior, Bureau of Land Management or by a decree of a Court of Law and/or that the corner points mentioned in lines 3, 4 and 5 above were in conformance with the rules of the Michigan Board of Land Surveyors or by a Decree of a Court of Law; established, re-established, monumented, re-monumented, recovered, found as expressed below:

**NOTE: Not more than 4 corners, all in the same town and range, may be recorded on this certificate.**

	A	B	C	D	E	F	G	H	I	J	K	L	M
2	6	5	4	3	2	1							
3													
4	7	8	9	10	11	12							
5													
6	18	17	16	15	14	13							
7													
8	19	20	21	22	23	24							
9													
10	30	29	28	27	26	25							
11													
12	31	32	33	34	35	36							
13													

A. Description of original monument and accessories and/or subsequent restoration:

B. Description of corner evidence found and/or method applied in restoring or reestablishing corner:

- E-2 - Set by single proportionate measurement and on line between found recorded section corners.
- E-1 - Found corner of record by N. C. Caldwell, L.S. and Mich. Dept. of State Highways.
- 3 - Set by standard survey procedure for subdivision of sections.
- 10 - Set by standard survey procedure for subdivision of sections.

C. Description of monument for corner and accessories established to perpetuate locating the position of the corner:


E-2 - W 1/4 Corner  
 Set DNR Mon. & cedar post  
 P. Pole w/nail N26°E 21.00'  
 Fence Corner Post S 58°E 13.5'  
 4" Aspen S70°W 56.2'  
 4" Twin Birch N60°W 61.7'  
 E of N-S Road 27' W of corner

E-1 - NW Corner  
 Found 1/2" rod, raised with 5/8" rod  
 4" Jack Pine N7°W 49.8'  
 Power Pole S54°E 53.71' (MSHD Tag)  
 Fence Cor. S39°E 49.24'  
 Fence Cor. S48°W 37.61' (MSHD Tag)  
 Cedar post due north 20.0'

3 - N 1/8 on /w. side  
 Set 5/8" bar & cedar post  
 5" J. Pine N80°E 4.5'  
 6" J. Pine S99°E 36.2'  
 Fence Corner N51°W 57.2'  
 E of N-S road 13.5' W of corner

10 - 5-1/8 Cor. on West side  
 5/8" rod w/cap & cedar post  
 No witnesses available.

Signed by Carl R. Johnson  
 Surveyor's Michigan License No. 30083

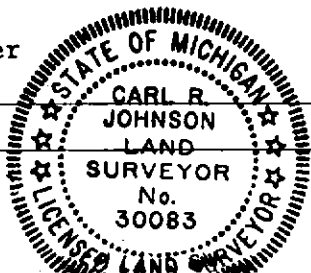

Date 1/4/88