

**LAND CORNER RECORDATION CERTIFICATE**  
**Filing Requirement of Act 74, Mich. P.A. 1970**

For corners in

<u>Roscommon</u> <small>(County)</small>	Located in:	Corner Code <del>##</del>
1. Public Land Survey	T <u>22N</u> R <u>1W</u>	<u>G-2</u>
	T <u>22N</u> R <u>1W</u>	<u>G-3</u>
	T <u>22N</u> R <u>1W</u>	<u>F-2</u>
	T <u>22N</u> R <u>1W</u>	<u>E-3</u>
2. Property Controlling in Section	S _____ T _____ R _____	_____
	S _____ T _____ R _____	_____
3. Miscellaneous Property in Sec.	S _____ T _____ R _____	_____
	S _____ T _____ R _____	_____

Register of Deeds Stamp & File Number

4. Lot No. \_\_\_\_\_, Recorded Plat \_\_\_\_\_  
 5. Private Claims \_\_\_\_\_

	A	B	C	D	E	F	G	H	I	J	K	L	M
2	6		5		4		3		2		1		
3													
4	7		8		9		10		11		12		
5													
6	13		14		15		16		17		18		
7													
8	19		20		21		22		23		24		
9													
10	25		26		27		28		29		30		
11													
12	31		32		33		34		35		36		
13													

I, Carl R. Johnson, in a field survey on January 8, 19 87, do hereby certify that under requirements of P.A. 74, Michigan P.A. of 1970, the corner points mentioned in lines 1 and 2 above were in conformance with regulations and rules therefore as required in the current manual of survey instructions of the United States Department of the Interior, Bureau of Land Management or by a decree of a Court of Law and/or that the corner points mentioned in lines 3, 4 and 5 above were in conformance with the rules of the Michigan Board of Land Surveyors or by a Decree of a Court of Law; established, re-established, monumented, re-monumented, recovered, found as expressed below:

**NOTE: Not more than 4 corners, all in the same town and range, may be recorded on this certificate.**

A. Description of original monument and accessories and/or subsequent restoration:

B. Description of corner evidence found and/or method applied in restoring or reestablishing corner:

- G-2 - Found 1/2" bar of record in place.
- G-3 - Found 1/2" bar of record in place by G.D. Henning, L.S., 1955.
- F-2 - Set corner at true completed intersection of 1/4 lines.
- E-3 - Found 1/2" bar in place as established and recorded by G.D. Henning, L.S., 1955.

C. Description of monument for corner and accessories established to perpetuate locating the position of the corner:


G-2 - E 1/4 Corner  
 Found 1/2" bar, set cedar post  
 8" Red Pine N69°E 42.3'  
 10" Red Pine S46°E 62.8'  
 7" Red Pine S73°W 56.3'  
 Centerline of N-S trail road  
 7' West of corner

G-3 - SE Corner  
 Found 1/2" bar at Fence Cor.  
 6" Maple N61°W 13.7'  
 7" Maple S34°E 20.0'  
 4" Maple N14°E 28.6'

F-2 - Center of Section  
 Set 5/8" bar w/cap & cedar post  
 10" Red Pine N20°E 58.8'  
 12" Ash S78°E 32.8'  
 18" Ash S26°W 85.5'

E-3 - SW Corner  
 Found 1/2" bar  
 8" Balsam S47°W 45.5'  
 6" Balsam N53°W 33.2'  
 P. Pole w/nail S78°E 26.83'  
 E of N-S road 9.5' west of corner

Signed by Carl R. Johnson  
 Surveyor's Michigan License No. 30083

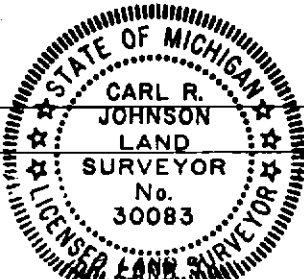

Date 1/14/87