

LAND CORNER RECORDATION CERTIFICATE
Filing Requirement of Act 74, Mich. P.A. 1970

For corners in

<u>Roscommon</u> <small>(County)</small>	Located In:	Corner Code <u>##</u>
1. Public Land Survey	T <u>22N</u> R <u>01W</u>	<u>K-7</u>
	T <u>22N</u> R <u>01W</u>	<u>J-7</u>
	T <u>22N</u> R <u>01W</u>	<u>I-7</u>
	T <u>22N</u> R <u>01W</u>	<u>J-5</u>
2. Property Controlling in Section	S _____ T _____ R _____	_____
	S _____ T _____ R _____	_____
3. Miscellaneous Property in Sec.	S _____ T _____ R _____	_____
	S _____ T _____ R _____	_____

Register of Deeds Stamp & File Number

4. Lot No. _____, Recorded Plat _____
 5. Private Claims _____

I, Carl R. Johnson, in a field survey on January 7, 1991, do hereby certify that under requirements of P.A. 74, Michigan P.A. of 1970, the corner points mentioned in lines 1 and 2 above were in conformance with regulations and rules therefore as required in the current manual of survey instructions of the United States Department of the Interior, Bureau of Land Management or by a decree of a Court of Law and/or that the corner points mentioned in lines 3, 4 and 5 above were in conformance with the rules of the Michigan Board of Land Surveyors or by a Decree of a Court of Law; established, re-established, monumented, re-monumented, recovered, found as expressed below.

NOTE: Not more than 4 corners, all in the same town and range, may be recorded on this certificate.

A	B	C	D	E	F	G	H	I	J	K	L	M
2	6	5	4	3	2	1						
3												
4	7	8	9	10	11	12						
5												
6	18	17	16	15	14	13						
7												
8	19	20	21	22	23	24						
9												
10	30	29	28	27	26	25						
11												
12	31	32	33	34	35	36						
13												

A. Description of original monument and accessories and/or subsequent restoration:


B. Description of corner evidence found and/or method applied in restoring or reestablishing corner:

- K-7 - Found corner of record in place
- J-7 - Set corner from witnesses by T. Lapham, L.L.S.
- I-7 - Found 1 1/2" I.P. of record in place.
- J-5 - Set corner by single proportionate measurement. No evidence of original or subsequent corner.

C. Description of monument for corner and accessories established to perpetuate locating the position of the corner:

<u>K-7 - SE Corner Sec. 14</u> Found 1/2" Iron Rod w/cap 27595 Oak 12" N54°E 26.5' Oak 14" N17°E 47.8' Oak 12" N72°W 55.9' Oak 10" S74°W 44.4' Oak 10" S22°W 16.5'	<u>J-7-S 1/4 Corner Sec 14</u> DNR Mon & Cedar Post Pine 4" N75°W 34.5' Oak 8" North 20.82' Oak 9" N20°E 15.5' Oak Stump (top center) Cedar Post North 10.0'	<u>I-7-SW Corner Sec 14</u> 1 1/2" I.P. 18" Below Rd Surface Oak 16" N58°E 58.4' R. Pine 12: N17°E 69.3' Oak 14" N28°W 71.95'	<u>J-5-Set 5/8" I.R. w/cap</u> Oak 5" S44°W 11.55' R. Pine 7" N02°E 11.7' Oak 6" S63°E 27.6' W. Pine 8" S29°E 42.2' R. Pine 10" S11°W 29.5' Nails & Brass tags at all points
--	---	---	--

Signed by Carl R. Johnson
 Surveyor's Michigan License No. 30083

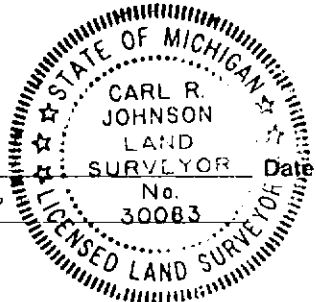

Date 2/19/91