

FEB 18 1994

9070  
COMMISSION

ROSCOMMON COUNTY REMONUMENTATION

LAND CORNER RECORDATION CERTIFICATE  
Filing Requirement of Act 74, Mich. P.A. 1970

STATE OF MICHIGAN  
COUNTY OF ROSCOMMON

Dec 21 10 51 AM '93

For corners in

<u>ROSCOMMON</u> (County)	Located In:	Corner Code #
1. Public Land Survey	T <u>22N</u> R <u>1W</u>	<u>A-6</u>
	T _____ R _____	_____
	T _____ R _____	_____
	T _____ R _____	_____
2. Property Controlling in Section	S _____ T _____ R _____	_____
	S _____ T _____ R _____	_____
3. Miscellaneous Property in Sec.	S _____ T _____ R _____	_____
	S _____ T _____ R _____	_____
4. Lot No. _____, Recorded Plat _____		
5. Private Claims _____		

ROSCOMMON COUNTY  
PEER GROUP APPROVAL  
DATE 11/30/93

TO BE FILED IN LIBER 3 OF LAND CORNERS  
Register of Deeds Stamp & File Number

TIMOTHY L. LAPHAM, in a field survey on November, 19 93,  
do hereby certify that under requirements of P.A. 74, Michigan P.A. of 1970, the corner points mentioned  
in lines 1 and 2 above were in conformance with regulations and rules therefore as required in the  
current manual of survey instructions of the United States Department of the Interior, Bureau of Land  
Management or by a decree of a Court of Law and/or that the corner points mentioned in lines 3, 4 and 5  
above were in conformance with the rules of the Michigan Board of Land Surveyors or by a Decree of a  
Court of Law; established, re-established, monumented, re-monumented, recovered, found as  
expressed below:

**NOTE: Not more than 4 corners, all in the same town and range, may be recorded  
on this certificate.**

A	B	C	D	E	F	G	H	I	J	K	L	M
2	6	5	4	3	2	1						
3												
4	7	8	9	10	11	12						
5												
6	18	17	16	15	14	13						
7												
8	19	20	21	22	23	24						
9												
10	30	29	28	27	26	25						
11												
12	31	32	33	34	35	36						
13												

A. Description of original monument and accessories and/or subsequent restoration:


A-6: 1837, J.BRINK, POST, HEMLOCK S65.5W 29LKS, SUGAR 10" N16.5W 45LKS;  
DATE UNKNOWN, SURVEYOR UNKNOWN, LCRC 2-61, CORNER MATERIAL, NO WITNESSES;  
6/1971, L.CAVANAGH, LCRC 1-13, COR MAT, NO WITNESSES;  
7/9/1977, L.CAVANAGH, (132) 335-227, NO COR MAT, NO WITNESSES;  
7/19/1977, HENNING, (132) 334-114, NO COR MAT, NO WITNESSES;  
1/15/1991, L.CAVANAGH, (132) 588-146, NO COR MAT, 1 WITNESS;  
6/10/1991, L.CAVANAGH, (132) 594-542, NO COR MAT, 1 WITNESS;

B. Description of corner evidence found and/or method applied in restoring or reestablishing corner:

A-6: FOUND CABIN SPIKE 3.5' NORTH OF FENCE LINE EAST IN CENTER LINE ROAD N-S  
1/2" BAR 33'E  
ACCEPTED FOUND CORNER AS BEST EVIDENCE OF POSITION OF ORIGINAL CORNER.  
THIS CORNER ESTABLISHED IN ROSCOMMON COUNTY REMONUMENTATION PROGRAM.  
SEE DOSSIER FOR DETAILED REPORT.

C. Description of monument for corner and accessories established to perpetuate locating the position of the corner:

A-6: SET 2" X 21" CAST IRON MONUMENT WITH BRASS ROSCOMMON COUNTY PLATE IN MONUMENT BOX  
AZ 90° 32.97' 1/2" IRON WITH CAP #17614  
AZ 56° 37.38' SPIKE IN NW FACE GATE POST  
AZ 337° 160.84' SPIKE IN NE FACE POWER POLE  
AZ 346° 139.30' SPIKE IN NW FACE 3" RED PINE

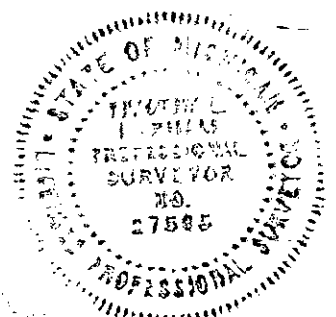

Signed by [Signature]

Date 12/20/93

Surveyor's Michigan License No. 27595

Date 11/30/93

Peer Group Approved

LIBER 3 PAGE 34