

9083
FEB 18 1994
COMMISSION

ROSCOMMON COUNTY REMONUMENTATION

LAND CORNER RECORDATION CERTIFICATE
Filing Requirement of Act 74, Mich. P.A. 1970

STATE OF MICHIGAN
COUNTY OF ROSCOMMON
REGISTER

Dec 21 10 51 AM '93

For corners in

ROSCOMMON (County)	Located In:	Corner Code #
1. Public Land Survey	T 22N R 1W	A-7
	T R	
	T R	
	T R	
2. Property Controlling in Section	S T R	
	S T R	
3. Miscellaneous Property in Sec.	S T R	
	S T R	
4. Lot No. _____, Recorded Plat _____		
5. Private Claims _____		

Robert J. Lapham
REGISTER

ROSCOMMON COUNTY
PEER GROUP APPROVAL
DATE 11/30/93

TO BE FILED IN LIBER 3 OF LAND CORNERS
Register of Deeds Stamp & File Number

I, TIMOTHY L. LAPHAM, in a field survey on November, 19 93, do hereby certify that under requirements of P.A. 74, Michigan P.A. of 1970, the corner points mentioned in lines 1 and 2 above were in conformance with regulations and rules therefore as required in the current manual of survey instructions of the United States Department of the Interior, Bureau of Land Management or by a decree of a Court of Law and/or that the corner points mentioned in lines 3, 4 and 5 above were in conformance with the rules of the Michigan Board of Land Surveyors or by a Decree of a Court of Law; established, re-established, monumented, re-monumented, recovered, found as expressed below:

NOTE: Not more than 4 corners, all in the same town and range, may be recorded on this certificate.

	A	B	C	D	E	F	G	H	I	J	K	L	M
2	6	5	4	3	2	1							
3													
4	7	8	9	10	11	12							
5													
6	18	17	16	15	14	13							
7													
8	19	20	21	22	23	24							
9													
10	30	29	28	27	26	25							
11													
12	31	32	33	34	35	36							
13													

A. Description of original monument and accessories and/or subsequent restoration:


A-7: 1937, J.BRINK, POST, BLACK ASH 14" S15W 21LKS, BLACK ASH 12" N54W 16LKS; 1952, W.BURT, BLACK ASH 8" S16E 20LKS, HEMLOCK 20" N10E 16LKS; DATE UNKNOWN, SURVEYOR UNKNOWN, LCRC 2-192, CORNER MATERIAL, 3 WITS; 6/11/1963, CALDWELL, CORNER CARD-SEE DOSSIER, NO COR MAT, NO WITS; 6/1971, L.CAVANAGH, LCRC 1-13, COR MAT, 3 WITS; 9/12/1974, L.CAVANAGH, (132) 297-211, NO COR MAT, 3 WITS; 7/19/1977, HENNING, (132) 334-114, NO COR MAT, NO WITS; 11/1985, LAPHAM, LCRC 1-235, COR MAT, 4 WITS; 4/3/1987, ARLETH, (132) 504-186, COR MAT, 2 WITS; 1/15/1991, L.CAVANAGH, (132) 588-146, COR MAT, 4 WITS;

B. Description of corner evidence found and/or method applied in restoring or reestablishing corner:

A-7: FOUND 1/2"X24" REROD OVER 3/4"X24" PINCH PIPE
N45W 49.77' 1/2" PIPE (DISTURBED)
S40E 38.30' SQUARE CHISELLED IN CONCRETE CULVERT (DISTURBED)
S45W 44.95' CORNER POST
N45W 62.72' POWER POLE
WEST 1.5' CENTER LINE PAVEMENT
ACCEPTED FOUND CORNER AS BEST EVIDENCE OF POSITION OF ORIGINAL CORNER.
THIS CORNER ESTABLISHED IN ROSCOMMON COUNTY REMONUMENTATION PROGRAM.
SEE DOSSIER FOR DETAILED REPORT.

C. Description of monument for corner and accessories established to perpetuate locating the position of the corner:

A-7: SET 2" X 21" CAST IRON MONUMENT WITH BRASS ROSCOMMON COUNTY PLATE IN MONUMENT BOX
AZ 315° 48.00' 1/2" CAPPED REBAR #2240
AZ 305° 62.81' SPIKE SW FACE POWER POLE
AZ 230° 44.90' SPIKE NW FACE CORNER POST
AZ 138° 37.47' CHISELLED X IN CULVERT 1'+/- FROM END
AZ 270° 1.5'+/- CENTER LINE PAVEMENT

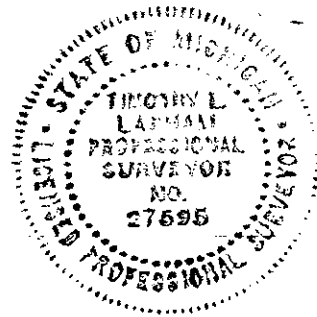

Signed by *Timothy L. Lapham* Date 12/20/93

Surveyor's Michigan License No. 27595

Date 11/30/93 Peer Group Approved

LIBER 3 PAGE 47