

**SURVEY &
REMONUMENTATION**

APR 07 1998

9236 SECTION

LAND CORNER RECORDATION CERTIFICATE
Filing Requirement of Act 74, Mich P.A. 1970

STATE OF MICHIGAN
ROSCOMMON COUNTY
RECORDED

16 DEC 97 12:22 P.M.

ROBERT W. SMITH
REGISTER OF DEEDS

For corners in
Roscommon County

Located in: Corner Code #

1. Public Land Survey

T23N	R 1W	C-13
T22N	R 1W	C-1
T	R	
T	R	

FILE IN LIBER 3 OF LAND CORNERS

Register of Deeds Stamp & File Number

I, Larry L. Cavanagh, in a field survey November, 1997, do hereby certify that under requirements of P.A. 74, Michigan P.A. of 1970, the corner points mentioned in line 1 above was in conformance with regulations and rules therefore as required in the current manual of survey instructions of the United States Department of the Interior, Bureau of Land Management or by a decree of a Court of Law; established, re-established, monumented, recovered, found as expressed below:

A. Description of original monument and accessories and/or subsequent restoration:

JOHN BRINK 1838
SET POST
WHITE PINE 28" N45W 13 LKS
WHITE PINE 24" N65E 46 LKS

DEPT OF CONSERVATION 1935±
DIRECTION OF MARCUS SCHAFF
FD 2 "MARKED" CEDAR
POSTS & US-BT'S (STUMPS)
SET 1" PIPE

CF ROSER 12028 1966
FD 2 "MARKED" SQ. CEDAR POSTS
TOGETHER AND 2 US-BT'S
(STUMPS)
SET 4.5' OF 1" PIPE (15" ABOVE GRD)
AND BRANDED CEDAR POST
7" MAPLE S10W 59.10
7" R. PINE S62E 51.59
5" MAPLE N65E 37.82
11" W. BIRCH N40E 44.13
US-BT 24" BLAZED W. PINE STUMP
N 65E 30.4' (TO FACE)
US-BT 28" BLAZED W. PINE STUMP
N45W 8' (TO FACE)
CENTER OF E-W RR GRADE DUE
SOUTH 83'
EAST EDGE OF LOW WET AREA DUE
EAST 10'
CTR. OF N-S BEAVER TRAVELED
STREAM BED DUE WEST 66'

1970'S L2 P149
1" X 4.5' PIPE & POST
(15" ABOVE GRD)
S10W 59.10' 7" MAPLE
S62E 51.19' 7" R. PINE
N65E 37.82' 5" MAPLE
N40E 44.13' 11" W.
BIRCH
DUE SOUTH 83' CTR
E-W RR GRADE
N65E 30.4' US-BT 24"
STUMP
N45W 8' US-BT 28"
STUMP

	A	B	C	D	E	F	G	H	I	J	K	L	M
2	6	5	4	3	2	1							
3													
4	7	8	9	10	11	12							
5													
6	18	17	16	15	14	13							
7													
8	19	20	21	22	23	24							
9													
10	30	29	28	27	26	25							
11													
12	31	32	33	34	35	36							
13													

B. Description of corner evidence found and/or method applied in restoring or reestablishing corner:

FOUND 1" X 4.5' PIPE 15" ABOVE GROUND
15" MAPLE S10°W 59.20'
19" R. PINE S62°E 51.47'
12" MAPLE N65°E 37.94'
11" W. BIRCH N40°E 44.13 (NOW LEANING)
US-BT 24" BLAZED W PINE STUMP N65°E 30.4' (TO FACE)
US-BT 28" BLAZED W. PINE STUMP N45°W 8' (TO FACE)


C. Description of monument for corner and accessories established to perpetuate locating the position of the corner:

FOUND 1" X 4.5' PIPE, LEFT IN PLACE. DROVE CAP 17614 INSIDE PIPE.
NAIL & TAG IN 15" MAPLE S10°W 59.20'
NAIL & TAG IN 19" R. PINE S62°E 51.47'
NAIL & TAG IN 12" MAPLE N65°E 37.94'
NAIL & TAG IN 14" MAPLE N48°E 40.81'
CARSONITE POST N45°W 2.0'

A PERPETUATION OF THE ORIGINAL GOVERNMENT CORNER.

ROSCOMMON COUNTY
PEER GROUP APPROVAL
DATE Dec 5, 1997

Marvin E. Myers
Marvin E. Myers, P.S.
County Surveyor

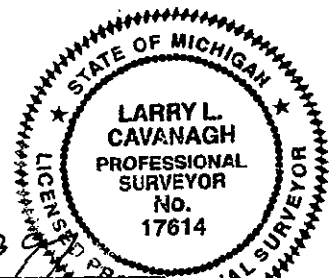

Signed by Larry L. Cavanagh Date Dec. 11, 1997
Surveyor's Michigan License NO. 17614

FORM APPROVED BY MICHIGAN STATE BOARD OF LAND SURVEYORS, JAN 28, 1971
REVISED MAY 14, 1975
REVISED JAN., 1983

LIBER 3 PAGE 461