

ROSCOMMON COUNTY REMONUMENTATION

LAND CORNER RECORDATION CERTIFICATE

Filing Requirement of Act 74, Mich. P.A. 1970

Dec 21 10 51 AM '93

*Robert L. Lapham*  
REGISTER

For corners in

ROSCOMMON (County)	Located In:	Corner Code #
1. Public Land Survey	T <u>22N</u> R <u>1W</u>	<u>C-5</u>
	T _____ R _____	_____
	T _____ R _____	_____
	T _____ R _____	_____
2. Property Controlling in Section	S _____ T _____ R _____	_____
	S _____ T _____ R _____	_____
3. Miscellaneous Property in Sec.	S _____ T _____ R _____	_____
	S _____ T _____ R _____	_____
4. Lot No. _____, Recorded Plat _____		
5. Private Claims _____		

**ROSCOMMON COUNTY  
PEER GROUP APPROVAL**  
DATE 11/30/93  
TO BE FILED IN LIBER 3 OF LAND CORNERS

Register of Deeds Stamp & File Number

I, **TIMOTHY L. LAPHAM**, in a field survey on November, 19 93, do hereby certify that under requirements of P.A. 74, Michigan P.A. of 1970, the corner points mentioned in lines 1 and 2 above were in conformance with regulations and rules therefore as required in the current manual of survey instructions of the United States Department of the Interior, Bureau of Land Management or by a decree of a Court of Law and/or that the corner points mentioned in lines 3, 4 and 5 above were in conformance with the rules of the Michigan Board of Land Surveyors or by a Decree of a Court of Law; established, re-established, monumented, re-monumented, recovered, found as expressed below:

**NOTE: Not more than 4 corners, all in the same town and range, may be recorded on this certificate.**

	A	B	C	D	E	F	G	H	I	J	K	L	M
2	6		5		4		3		2		1		
3													
4	7		8		9		10		11		12		
5													
6	18		17		16		15		14		13		
7													
8	19		20		21		22		23		24		
9													
10	30		29		28		27		26		25		
11													
12	31		32		33		34		35		36		
13													

A. Description of original monument and accessories and/or subsequent restoration:


C-5: 1852, W.BURT, POST, HEMLOCK 12" N78W 29LKS, SUGAR 10" S26E 30LKS; DATE UNKNOWN, SURVEYOR UNKNOWN, LCRC 2-151, CORNER MATERIAL, 4 WITNESSES; 6/11/1963, CALDWELL, CORNER RECORD CARD-SEE DOSSIER, NO COR MAT, NO WITS; 6/2/1971, L.CAVANAGH, (132) 253-607, NO COR MAT, NO WITS; 6/1971, L.CAVANAGH, LCRC 1-13, COR MAT, NO WITS; 5/27/1975, L.CAVANAGH, (132) 317-402, COR MAT, NO WITS; 3/22/1976, L.CAVANAGH, (132) 316-297, NO COR MAT, NO WITS; 12/6/1976, ARLETH, (132) 325-204, COR MAT, NO WITS; 5/25/1977, HIGGINS, (132) 332-595, NO COR MAT, NO WITS; 5/4/1979, ARLETH, (132) 373-676, COR MAT, 3 WITS; 6/10/1981, L.CAVANAGH, (132) 390-653, NO COR MAT, 3 WITS;

B. Description of corner evidence found and/or method applied in restoring or reestablishing corner:

C-5: FOUND 1/2" PINCH PIPE IN MONUMENT BOX, EXCAVATED TO 3 FEET, FOUND NOTHING POWER POLE N40W 102.7' 14" ELM NORTH 144.45' (STUMP) NE BUILDING CORNER S50W 122.06' NW BUILDING CORNER S55E 135.52' ACCEPTED FOUND CORNER AS BEST EVIDENCE OF POSITION OF ORIGINAL CORNER. THIS CORNER ESTABLISHED IN ROSCOMMON COUNTY REMONUMENTATION PROGRAM. SEE DOSSIER FOR DETAILED REPORT.

C. Description of monument for corner and accessories established to perpetuate locating the position of the corner:

C-5: SET 2" X 21" CAST IRON MONUMENT WITH BRASS ROSCOMMON COUNTY PLATE AZ 0° 147.94' SPIKE IN WEST FACE 12" TWIN ASH AZ 320° 102.62' MSHD TAG IN NE FACE POWER POLE AZ 220° 122.03' NE CORNER OF HOUSE NO. 6978 AZ 130° 135.10' NW CORNER OF SHED ROOFED ADDITION TO OLD SCHOOL HOUSE AZ 270° 24'+/- INTERSECTION C/L ROADS E-W-S

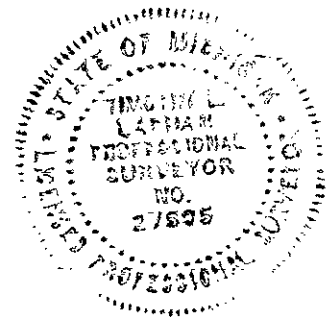

Signed by *Timothy L. Lapham* Date 12/20/93

Surveyor's Michigan License No. 27595

Date 11/30/93 Peer Group Approved

LIBER **3** PAGE **31**