

ROSCOMMON COUNTY REMONUMENTATION

Dec 21 10 51 AM '93

9066

LAND CORNER RECORDATION CERTIFICATE
Filing Requirement of Act 74, Mich. P.A. 1970

For corners in

<u>ROSCOMMON</u> (County)	Located In:	Corner Code #
1. Public Land Survey	T <u>22N</u> R <u>1W</u>	<u>C-6</u>
	T _____ R _____	_____
	T _____ R _____	_____
	T _____ R _____	_____
2. Property Controlling in Section	S _____ T _____ R _____	_____
	S _____ T _____ R _____	_____
3. Miscellaneous Property in Sec.	S _____ T _____ R _____	_____
	S _____ T _____ R _____	_____
4. Lot No. _____, Recorded Plat _____		
5. Private Claims _____		

Robert L. Lapham
REGISTER

**ROSCOMMON COUNTY
PEER GROUP APPROVAL
DATE 11/30/93**

**TO BE FILED IN LIBER 3 OF LAND CORNERS
Register of Deeds Stamp & File Number**

I, TIMOTHY L. LAPHAM, in a field survey on November, 19 93, do hereby certify that under requirements of P.A. 74, Michigan P.A. of 1970, the corner points mentioned in lines 1 and 2 above were in conformance with regulations and rules therefore as required in the current manual of survey instructions of the United States Department of the Interior, Bureau of Land Management or by a decree of a Court of Law and/or that the corner points mentioned in lines 3, 4 and 5 above were in conformance with the rules of the Michigan Board of Land Surveyors or by a Decree of a Court of Law; established, re-established, monumented, re-monumented, recovered, found as expressed below:

	A	B	C	D	E	F	G	H	I	J	K	L	M
2	6		5		4		3		2		1		
3													
4	7		8		9		10		11		12		
5													
6	18		17		16		15		14		13		
7													
8	19		20		21		22		23		24		
9													
10	30		29		28		27		26		25		
11													
12	31		32		33		34		35		36		
13													


NOTE: Not more than 4 corners, all in the same town and range, may be recorded on this certificate.

A. Description of original monument and accessories and/or subsequent restoration:

C-6: 1852, W.BURT, POST, BEECH 6" N22W 16LKS, BEECH 6" S45E 20LKS;
DATE UNKNOWN, SURVEYOR UNKNOWN, LCRC 2-160, CORNER MATERIAL, 3 WITNESSES;
6/11/1963, CALDWELL, CORNER RECORD CARD-SEE DOSSIER, COR MAT, 3 WITS;
6/1971, L.CAVANAGH, LCRC 1-13, COR MAT, 3 WITS;
3/22/1976, L.CAVANAGH (132) 316-296, NO COR MAT, NO WITS;
6/10/1981, L.CAVANAGH (132) 390-643, COR MAT, 3 WITS;
1/15/1991, L.CAVANAGH (132) 588-146, NO COR MAT, 3 WITS;
6/10/1991, L.CAVANAGH (132) 594-542, NO COR MAT, 3 WITS;

B. Description of corner evidence found and/or method applied in restoring or reestablishing corner:

C-6: FOUND 1/2" PINCH PIPE, EXCAVATED TO 3 FOOT, NOTHING ELSE FOUND
WEST 42.40' POWER POLE
S17W 57.82' 14" ELM (STUMP BADLY DETERIORATED)
N75E 28.98' 12" OAK
ACCEPTED FOUND CORNER AS BEST EVIDENCE OF POSITION OF ORIGINAL CORNER.
THIS CORNER ESTABLISHED IN ROSCOMMON COUNTY REMONUMENTATION PROGRAM.
SEE DOSSIER FOR DETAILED REPORT.

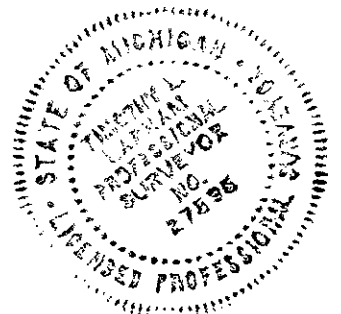

C. Description of monument for corner and accessories established to perpetuate locating the position of the corner:

C-6: SET 2" X 21" CAST IRON MONUMENT WITH BRASS ROSCOMMON COUNTY PLATE
AZ 85° 28.97' SET SPIKE IN SOUTH FACE 20" OAK
AZ 265° 42.35' MSHD TAG IN SOUTH FACE POWER POLE
AZ 210° 58.43' SPIKE IN NW FACE 8" CEDAR
AZ 20° 52.53' SPIKE IN SE FACE 11" MAPLE
AZ 270° +/- 15' +/- CENTER LINE DRIVEWAY
AZ 90° 1.03' CARSONITE SURVEY MARKER POST
NOTE: CORNERS AT APPROX. EAST RIGHT OF WAY OF ROAD AND APPROX. TREE LINE EAST AND WEST.

Signed by *Timothy L. Lapham* Date 12/20/93
Surveyor's Michigan License No. 27595

Date 11/30/93 Peer Group Approved
LIBER **3** PAGE **30**