

**SURVEY &  
REMONUMENTATION**

APR 07 1998

SECTION

9233

**LAND CORNER RECORDATION CERTIFICATE**  
Filing Requirement of Act 74, Mich P.A. 1970

STATE OF MICHIGAN  
ROSCOMMON COUNTY  
RECORDED

16 DEC 97 12:21 P.M.

ROBERT W. SMITH  
REGISTER OF DEEDS

For corners in  
Roscommon County

Located in: Corner Code #

1. Public Land Survey

T23N	R1W	F-13
T22N	R1W	F-1
T	R	
T	R	

FILE IN LIBER 3 OF LAND CORNER  
Register of Deeds Stamp & File Number

I, Larry L. Cavanagh, in a field survey November, 1997, do hereby certify that under requirements of P.A. 74, Michigan P.A. of 1970, the corner points mentioned in line 1 above was in conformance with regulations and rules therefore as required in the current manual of survey instructions of the United States Department of the Interior, Bureau of Land Management or by a decree of a Court of Law; established, re-established, monumented, recovered, found as expressed below:

	A	B	C	D	E	F	G	H	I	J	K	L	M
2	6	5	4	3	2	1							
3													
4	7	8	9	10	11	12							
5													
6	18	17	16	15	14	13							
7													
8	19	20	21	22	23	24							
9													
10	30	29	28	27	26	25							
11													
12	31	32	33	34	35	36							
13													

A. Description of original monument and accessories and/or subsequent restoration:

JOHN BRINK 1838  
SET POST  
WHITE PINE 8" N44 1/2 W 20 LKS  
WHITE OAK 6" N36E 28 LKS

NORMAN C. CALDWELL 12018 1966  
SET 3/4" BAR BY SINGLE PROP  
S30°W 45.95 FE COR POST  
S07°E 43.94 11" B. OAK  
S42°E 81.39 10" B. OAK

B. Description of corner evidence found and/or method applied in restoring or reestablishing corner:

FOUND PAVEMENT BOX, NO MONUMENT  
FENCE CORNER POST S30°W 45.95'


C. Description of monument for corner and accessories established to perpetuate locating the position of the corner:

SET ROSCOMMON COUNTY MONUMENT STAMPED 17614, 1997  
NAIL & TAG IN 8" R. OAK N45°E 134.88'  
NAIL & TAG IN 5" W. PINE SOUTH 47.97'  
NAIL & TAG IN 8" W. PINE S20°W 48.45'  
NAIL & TAG IN FENCE CORNER S30°W 45.90'  
NAIL & TAG IN 8" MAPLE S65°W 102.05'  
CARSONITE POST NORTH 21.9'

THE BEST AVAILABLE EVIDENCE OF THE POSITION OF THE ORIGINAL CORNER.

**ROSCOMMON COUNTY  
PEER GROUP APPROVAL  
DATE Dec 5, 1997**

*Marvin E. Myers*  
Marvin E. Myers, P.S.  
County Surveyor

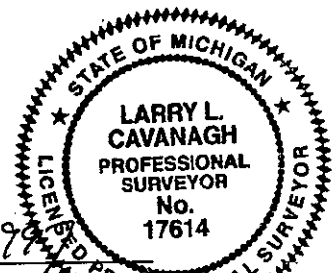

Signed by *Larry L. Cavanagh* Date *Dec. 11, 1997*  
Surveyor's Michigan License No. 17614

FORM APPROVED BY MICHIGAN STATE BOARD OF LAND SURVEYORS, JAN 25, 1971  
REVISED MAY 14, 1975  
REVISED JAN., 1983

LIBER 3 PAGE 458