

**SURVEY &
REMONUMENTATION**

APR 07 1998

9232

SECTION

LAND CORNER RECORDATION CERTIFICATE
Filing Requirement of Act 74, Mich P.A. 1970

STATE OF MICHIGAN
ROSCOMMON COUNTY
RECORDED

For corners in
Roscommon County

16 DEC 97 12:21 P.M.

ROBERT W. SMITH
REGISTER OF DEEDS

I. Public Land Survey

Located in:	Corner Code #
T23N R 1W	G-13
T22N R 1W	G-1
T R	
T R	

FILE IN LIBER 3 OF LAND CORNERS
Register of Deeds Stamp & File Number

I, Larry L. Cavanagh, in a field survey November, 1997, do hereby certify that under requirements of P.A. 74, Michigan P.A. of 1970, the corner points mentioned in line 1 above was in conformance with regulations and rules therefore as required in the current manual of survey instructions of the United States Department of the Interior, Bureau of Land Management or by a decree of a Court of Law; established, re-established, monumented, recovered, found as expressed below:

	A	B	C	D	E	F	G	H	I	J	K	L	M
2	6	5	4	3	2	1							
3													
4	7	8	9	10	11	12							
5													
6	18	17	16	15	14	13							
7													
8	19	20	21	22	23	24							
9													
10	30	29	28	27	26	25							
11													
12	31	32	33	34	35	36							
13													

A. Description of original monument and accessories and/or subsequent restoration:

JOHN BRINK 1838
SET POST
WHITE PINE 11 N71 1/2E 62
YELLOW PINE 14 N47W 35

NORMAN C. CALDWELL 12018 1966
FD 1" PIPE AS SET BY G. HENNING FROM
ORIG. SURVEY BEARING TREE
N35°E 43.47' 11" OAK (NBT)
N18°E 80.54' 15" TW OAK
N27°W 81.53' 14" OAK
N47°W 46.50' 9" OAK (NBT)
S45°E 46.20' 24" W. PINE STUMP (ORIG. BT)

WILLIAM BURT 1852
Y. PINE 14 S56W 22 LKS
W. PINE 24 S45E 70 LKS

1970'S L2 P147
1" PIPE
N35°E 43.47' 11" OAK
N18°E 80.54' 15" TW OAK
N27°W 81.53' 14" OAK
N47°W 46.50' 9" OAK (NBT)
S45°E 46.20' 24" W. PINE STUMP

GEORGE D. HENNING 1947
ORIG. US SURVEY CORNER
FD US BT
24" W. PINE STP S45°E 46.2 (US BT)
9" B. OAK N35°E 43.3 (N BT)
8" B. OAK N47W 46.4 (N BT)
1" X 24" PIPE IN CORNER

B. Description of corner evidence found and/or method applied in restoring or reestablishing corner:

FOUND PAVEMENT BOX, NO MONUMENT
(E-13 TO F-13) MSHD N89°44'44"W 2648.76', MEASURED N89°44'52"W 2648.97'
(F-13 TO G-13) MSHD N89°44'44"W 2648.76', MEASURED N89°44'30"W 2648.85'

C. Description of monument for corner and accessories established to perpetuate locating the position of the corner:


SET ROSCOMMON COUNTY MONUMENT STAMPED 17614, 1997
NAIL & TAG IN 20" R. OAK N48°W 63.64'
NAIL & TAG IN 6" R. OAK N21°E 80.24'
NAIL & TAG IN 4" W. OAK S37°E 60.60'
NAIL & TAG IN 5" W. PINE S69°W 156.04'
CARSONITE POST NORTH 19.2'

A PERPETUATION OF THE ORIGINAL GOVERNMENT CORNER.

ROSCOMMON COUNTY
PEER GROUP APPROVAL
DATE Dec 5, 1997

Marvin E. Myers
Marvin E. Myers, P.S.
County Surveyor

Signed by Larry L. Cavanagh Date Dec. 11, 1997
Surveyor's Michigan License NO. 17614

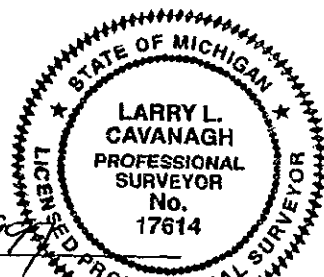

FORM APPROVED BY MICHIGAN STATE BOARD OF LAND SURVEYORS, APRIL 28, 1971
REVISED MAY 14, 1975
REVISED JAN., 1983

LIBER 3 PAGE 457