

**SURVEY &
REMONUMENTATION**

OCT 05 1998

4586

SECTION

**LAND CORNER RECORDATION CERTIFICATE
Filing Requirement of Act 74, Mich. P.A. 1970**

For corners in

Roscommon
(County)

Located In:

Corner Code #

- | | | |
|---------------------------------------|--------------------------|-------------|
| 1. Public Land Survey | T <u>22N</u> R <u>1W</u> | <u>M-10</u> |
| | T _____ R _____ | _____ |
| | T _____ R _____ | _____ |
| | T _____ R _____ | _____ |
| 2. Property Controlling
in Section | S _____ T _____ R _____ | _____ |
| | S _____ T _____ R _____ | _____ |
| 3. Miscellaneous
Property in Sec. | S _____ T _____ R _____ | _____ |
| | S _____ T _____ R _____ | _____ |
| 4. Lot No. _____, Recorded Plat _____ | | |
| 5. Private Claims _____ | | |

STATE OF MICHIGAN
ROSCOMMON COUNTY
RECORDED

8 JUN 98 10:12 A.M.

ROBERT W. SMITH
REGISTER OF DEEDS

FILE IN LIBER 3 OF LAND CORNERS
Register of Deeds Stamp & File Number

I, Marvin E. Myers, in a field survey on 3-26, 1998, do hereby state that under requirements of P.A. 74, Michigan P.A. of 1970, the corner points mentioned in lines 1 and 2 above were in conformance with regulations and rules therefore as required in the current manual of survey instructions of the United States Department of the Interior, Bureau of Land Management or by a decree of a Court of Law and /or that the corner points mentioned in lines 3, 4 and 5 above were in conformance with the rules of the Michigan Board of Land Surveyors or by a Decree of a Court of Law, established, re-established, monumented, recovered, found as expressed below.

NOTE: Not more than 2 corners, all in the same town and range, may be recorded on this certificate.

1	A	B	C	D	E	F	G	H	I	J	K	L	M
2	6	5	4	3	2	1							
3													
4	7	8	9	10	11	12							
5													
6	18	17	16	15	14	13							
7													
8	19	20	21	22	23	24							
9													
10	30	29	28	27	26	25							
11													
12	31	32	33	34	35	36							
13													

A. Description of original monument and accessories and/or subsequent restoration:

M-10 GLO - 1837 John Brink, D.S.
Mon. - Post
20" Yellow Pine S42°W 19 Lss.
16" Yellow Pine N64°W 70 Lss.

Marcus Schaaf, RLS early 1900s
Found or established and replaced

George D. Henning, RLS #2240 May 1967
Mon - Computed position did not set or witness.

L. 6, Pg. 9 (Duane F. Ledy P.S. #21575 12-1-94)
Mon. - Found 2" Pipe
West ±2' to Center Line 2-Track Trail

Spikes in:
4" Poplar West 19.55'
3" Oak N30°W 26.60'
3" Maple N30°E 34.38'
3" Oak S25°E 39.30'

L. 3, Pg., 46 (R. L. Higgins, P.S. 21570 June 14, 1979)
Mon - Not given, based on unrecorded Henning Survey.

B. Description of corner evidence found and/or method applied in restoring or reestablishing corner:

Found 1½" Iron pipe in concrete, 2' East of centerline of North-South trail road. Pipe typical Marcus Schaaf monument from the early 1900's. Found nail in the S. side of a 6" Poplar N86°W 19.50'. Found nail in the NE. side of a 4" Cherry N53°W 26.61'. Found nail in the SW. side of a 6" Oak S20°E 39.34'. Found nail in the W. side of a 4" Maple N25°E 34.40'. Discussed the Higgins & Henning position at length, which was rejected in favor of the Schaaf monument. Accepted as best available evidence of the position of the Original Government Corner. Replaced 1½" Iron Pipe with Standard County Monument.


C. Description of monument for corner and accessories established to perpetuate locating the position of the corner:

Mon.- Standard Roscommon County Monument
Found nail in the S. side of a 6" Poplar N86°W 19.50'
Found nail in the NE. Side of a 4" Cherry N53°W 26.61'
Found nail in the SW. side of a 6" Oak S20°E 39.34'
Found nail in the W. side of a 4" Maple N25°E 34.40'

**ROSCOMMON COUNTY
PEER GROUP APPROVAL
DATE MAY 15 1998**

Marvin E. Myers
Marvin E. Myers, P.S.
County Surveyor

Signed by *Marvin E. Myers*
Surveyor's Michigan License No. 31600

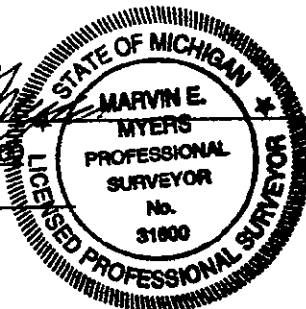

Date June 5th 1998