

LAND CORNER RECORDATION CERTIFICATE
Filing Requirement of Act 74, Mich. P.A. 1970

For corners in

Roscommon Located In: Corner Code ##
(County)

1. Public Land Survey T 22N R 2W D-11
T 22N R 2W C-10
T 22N R 2W C-09
T 22N R 2W D-09

2. Property Controlling S _____ T _____ R _____
in Section S _____ T _____ R _____

3. Miscellaneous S _____ T _____ R _____
Property in Sec. S _____ T _____ R _____

Register of Deeds Stamp & File Number

4. Lot No. _____, Recorded Plat _____
5. Private Claims _____

I, Carl R. Johnson, in a field survey on April 4, 19 90, do hereby certify that under requirements of P.A. 74, Michigan P.A. of 1970, the corner points mentioned in lines 1 and 2 above were in conformance with regulations and rules therefore as required in the current manual of survey instructions of the United States Department of the Interior, Bureau of Land Management or by a decree of a Court of Law and/or that the corner points mentioned in lines 3, 4 and 5 above were in conformance with the rules of the Michigan Board of Land Surveyors or by a Decree of a Court of Law; established, re-established, monumented, re-monumented, recovered, found as expressed below:

	A	B	C	D	E	F	G	H	I	J	K	L	M
2	6	5	4	3	2	1							
3													
4	7	8	9	10	11	12							
5													
6	18	17	16	15	14	13							
7													
8	19	20	21	22	23	24							
9													
10	30	29	28	27	26	25							
11													
12	31	32	33	34	35	36							
13													

NOTE: Not more than 4 corners, all in the same town and range, may be recorded on this certificate.


A. Description of original monument and accessories and/or subsequent restoration:

B. Description of corner evidence found and/or method applied in restoring or reestablishing corner:
D-11 Found DNR Mon. set by Ostling, Dept. of Natural Resources.

C-10 Found 1/2" rerod and witnesses from previous Department survey.

C-09 Found 1-1/2 pipe set in cement corner set by Schaff.

D-09 Found 1-1/2" I.P. in cement set by Schaff.

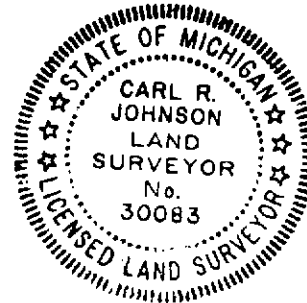

C. Description of monument for corner and accessories established to perpetuate locating the position of the corner:

D-11 1/4 Corner
DNR Monument
Red pine 18" - S10°W - 79.3'
Triple Maple 8" & 12" S79°W 69.2'
Double Maple 6" & 10" N10°W 39.2
Oak 10" S74°E 57.5'

C-9 1-1/2" Pipe set in cement
Oak 14" N81°E 47.51'
Oak 12" S58°E 49.85'
Jack Pine 6" S03°W 18.35'
Tamarack 6" N14°W 31.26'
Cedar Post North 8.0'

C-10 1/4 Corner
1/2" rerod
Oak 4" N10°W 30.8' Oak 14 S13°W 94.4'
W. Pine 6" N55°E 41.3'
Oak 14" N83°E 43.4'

D-9 Found 1-1/2" I.P. set in cement
Red Pine 14" S25°W 25.7'
White Pine 8" S30°E 33.9'
Apple 10" N74°E 44.9'
Jack Pine 8" N72°E 58.8'

Signed by Carl R. Johnson
Surveyor's Michigan License No. 30083

Date 5/10/90