LAND CORNER RECORDATION CERTIFICATE Filing Requirement of Act 74, Mich. P.A. 1970


For	COLUBER	in


Roscommon	Located In:	Corner Code ##	
(County)			
Public Land Survey	т <u>22</u> R <u>2W</u>	<u>C-11</u>	
	T R		
	T R		
	T R		
2. Property Controlling	S 29 T _ 22N R _ 2W	16	
in Section	s 29 T 22N R 2W	13	
3. Miscellaneous	S T R		
Property in Sec.	S T R		

Register of Deeds Stamp & File Number

- . Recorded Plat ___ 4. Lot No. 5. Private Claims
- . 19 _90 L Carl R. Johnson , in a field survey on April 25, do hereby certify that under requirements of P.A. 74, Michigan P.A. of 1970, the corner points mentioned in lines 1 and 2 above were in conformance with regulations and rules therefore as required in the current manual of survey instructions of the United States Department of the Interior, Bureau of Land Management or by a decree of a Court of Law and/or that the corner points mentioned in lines 3, 4 and 5 above were in conformance with the rules of the Michigan Board of Land Surveyors or by a Decree of a Court of Law; established, re-established, monumented, re-monumented, recovered, found as expressed below:

NOTE: Not more than 4 corners, all in the same town and range, may be recorded on this certificate.

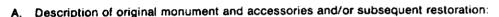

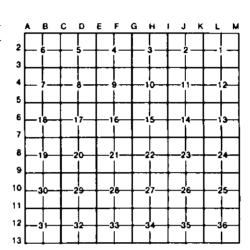

- B. Description of corner evidence found and/or method applied in restoring or reestablishing corner:
 - Found monument in place by previous department survey. C-11
 - Set by standard survey procedure for subdivision of a section. 16
 - Set by standard survey procedure for subdivision of a section. 13
- C. Description of monument for corner and accessories established to perpetuate locating the position of the corner:

SW Corner Section 29 C-11

- N72° E - 55.6 Found DNR monument. Cedar 6"

8" - NO9° W 81.8 Maple

16 E 1/8 corner on South line Section 29

5/8" iron rod with RLS cap

Pine stump 40" S54°E - 20.8'

\$27°W - 34.6' Balsam 6"

13 Center 1/8 corner of SE 1/4 Section 29

5/8" iron rod with RLS cap

Cedar 9" - NO8°E 25.6'

Cedar 9" S24°E 10.11

N730W Cedar 8" Signed by .

MINIMUM MINIMUM E OF MICHIGA JOHNSON URVEYOR THE LAND SUN No.