LAND CORNER RECORDATION CERTIFICATE

Filing Requirement of Act 74, Mich. P.A. 1970

For corners in ROSCOMMON (County)

	Located In:	Corner Code #/#
1. Public Land Survey	T 23N R 2W	D-3,E-2
	T ___ R ___	E-3
	T ___ R ___	
	T ___ R ___	
2. Property Controlling	S ___ T ___ R ___	
in Section	S ___ T ___ R ___	
3. Miscellaneous	S ___ T ___ R ___	
Property in Sec.	S ___ T ___ R ___	

Register of Deeds Stamp & File Number

4. Lot No. _____ , Recorded Plat _____
5. Private Claims _____

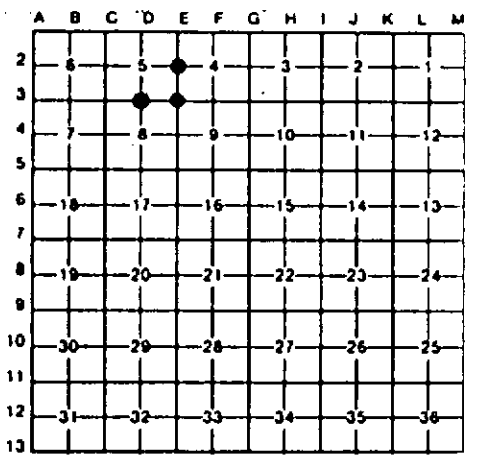

I, C.F.ROSER, in a field survey on MAY 19, 19 95, do hereby certify that under requirements of P.A. 74, Michigan P.A. of 1970, the corner points mentioned in lines 1 and 2 above were in conformance with regulations and rules therefore as required in the current manual of survey instructions of the United States Department of the Interior, Bureau of Land Management or by a decree of a Court of Law and/or that the corner points mentioned in lines 3, 4 and 5 above were in conformance with the rules of the Michigan Board of Land Surveyors or by a Decree of a Court of Law; established, re-established, monumented, re-monumented, recovered, found as expressed below:

NOTE: Not more than 4 corners, all in the same town and range, may be recorded on this certificate.

A. Description of original monument and accessories and/or subsequent restoration:

D-3 E-2 E-3

(NO EVIDENCE OF G.L.O. CORNER, B.T'S, LINE TREES & TOPOGRAPHY, AS CALLED OUT IN THE G.L.O. LINE NOTES; UNLESS NOTED IN ITEM "B" BELOW.)

B. Description of corner evidence found and/or method applied in restoring or reestablishing corner:

D-3

FD PIPE, PROBABLY BY M.SCHAAF (CONSERVATION DEPT. FORESTER / RLS, 1910'S TO 50'S±) FOR S1/4 COR S-5. FD 30"-40" PINE STP. N56°W, 10'; POSS. GLO WIT.(GLO = W.PINE 36", N65°W 16LKS - 10.6'). COR IS ON WEST END OF SMALL ISLAND IN SWAMP AS CALLED FOR IN US-GLO LINE NOTES.

E-2

FD PIPE FOR E1/4 COR S-5. PIPE PROBABLY SET BY M.SCHAAF IN 1920'S±, CONSERVATION DEPT. SURVEY. SCHAAF NOTES (IN CONS. DEPT. FIELD COPY OF GLO-PENCIL IN MARGIN) INDICATE HE HAD ORIG. USBT (LIVE); GLO= B.OAK, N57°W, 20 LINKS.

E-3

FD PIPE (PROBABLY BY M.SCHAAF, 1910'S- 50'S±, CONS. DEPT. SURVEYOR) FOR SE COR S-5.

C. Description of monument for corner and accessories established to perpetuate locating the position of the corner:

D-3

FD 2 1/4" PIPE.

4" W.PINE	S54°W	11.1'
10" W.PINE	N22°E	29.1'
12" W.PINE	S76°E	45.5'
7" W.PINE	S16°E	39.9'

E-2

FD 2"x 34" HIGH PIPE, SET CEDAR POST.

10" OAK	N70°E	4.92'
18" R.PINE	N46°W	19.73'
8" OAK	S37°W	21.61'
6" OAK	S52°E	18.96'

ALL TREES HAVE UPPER BLAZE.

E-3

FD 2" PIPE; SET CEDAR POST.

6"-10"MAPLE-CLP	N18°W	10.26'
4" W.PINE	N85°E	43.87'
4" W.PINE	S32°E	46.38'
30" OAK	S15°W	14.06'

ALL TREES HAVE UPPER BLAZE.

STATE OF MICHIGAN
CARL F. ROSER
LAND SURVEYOR
No. 12028
REGISTERED LAND SURVEYOR

Signed by Carl F. Roser 12028 Date 6-08-95

Surveyor's Michigan License No. _____

FORM APPROVED BY MICHIGAN STATE BOARD OF LAND SURVEYORS, JAN. 26, 1971
REVISED MAY 14, 1975
REVISED JAN. 1983