LAND CORNER RECORDATION CERTIFICATE
Filing Requirement of Act 74, Mich. P.A. 1970

For corners in ROSCOMMON (County)

	Located In:	Corner Code ##
1. Public Land Survey	T 23N R 2W	E-1,D-1
	T ___ R ___	
	T ___ R ___	
	T ___ R ___	
2. Property Controlling in Section	S 5 T ___ R ___	5
	S ___ T ___ R ___	
3. Miscellaneous Property in Sec.	S ___ T ___ R ___	
	S ___ T ___ R ___	

Register of Deeds Stamp & File Number

4. Lot No. _____ , Recorded Plat _____
5. Private Claims _____

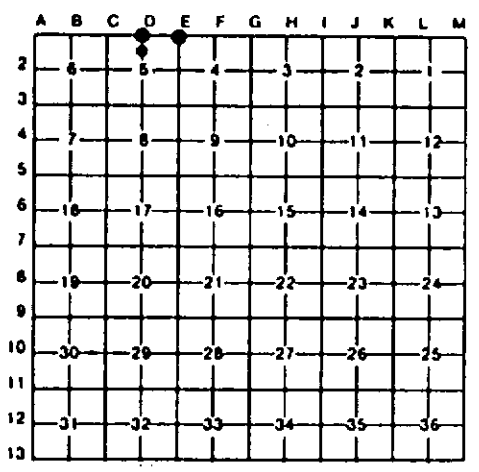

I, C.F.ROSER, in a field survey on MAY 19, 19 95, do hereby certify that under requirements of P.A. 74, Michigan P.A. of 1970, the corner points mentioned in lines 1 and 2 above were in conformance with regulations and rules therefore as required in the current manual of survey instructions of the United States Department of the Interior, Bureau of Land Management or by a decree of a Court of Law and/or that the corner points mentioned in lines 3, 4 and 5 above were in conformance with the rules of the Michigan Board of Land Surveyors or by a Decree of a Court of Law; established, re-established, monumented, re-monumented, recovered, found as expressed below:

NOTE: Not more than 4 corners, all in the same town and range, may be recorded on this certificate.

A. Description of original monument and accessories and/or subsequent restoration:

E-1	5	D-1
(NO EVIDENCE OF G.L.O. CORNER, B.T'S, LINE TREES & TOPOGRAPHY, AS CALLED OUT IN THE G.L.O. LINE NOTES; UNLESS NOTED IN ITEM "B" BELOW.)		

B. Description of corner evidence found and/or method applied in restoring or reestablishing corner:

E-1	5	D-1
FD PIPE IN CONC. FOR NE COR OF SEC.5. COR WAS FD. AND RECORDED (SE COR S-32, T24N-R2W, CODE E-13) BY RLS K.J.OSTLING IN 1983 DNR SURVEY. COR HAD BEEN LOCATED & USED BY G.F.DELAMATER (1929) & G.D.HENNING. K.J.O. NOTED "OBT STUMPS IN PLACE".	ESTABLISHED NE CORNER OF S1/2 OF NW1/4 PER STANDARD BLM INSTRUCTIONS.	N1/4 COR S-5; K.J.OSTLING, PS #10068, SET DNR MON IN 1983 DEPT. SURVEY (FOR S1/4 OF S-32, T24N-R2W) FROM NBT'S BY G.F.DELAMATER IN 1929.

C. Description of monument for corner and accessories established to perpetuate locating the position of the corner:

E-1			5			D-1		
FD 1 1/4" PIPE IN CONC. AND CEDAR POST.			SET DNR MON.			FD DNR MON & CEDAR POST.		
			14" TRI. OAK	S20°E	14.10'	10" HEMLOCK	N34°W	50.7'
#12" OAK	N10°E	49.91'	4" BALSAM	S65°E	21.25'	16" CEDAR	N69°W	26.5'
#10" OAK	S55°E	25.14'	12" TRI. OAK	N70°W	3.90'	6" CEDAR	S37°W	21.5'
6" OAK	S78°W	27.89'	SET CED POST	N65°E	1.02'			
14" TW.OAK	N35°W	25.23'	CTR. E-W 2-TRACK	SOUTH	5'	THESE ARE K.J.OSTLING 1983 WIT'S, STILL GOOD.		
#OLD PINE STP	N31°W	37.1'						

#=OLD WITNESSES.
ALL TREES HAVE UPPER BLAZE.

STATE OF MICHIGAN — CARL F. ROSER LAND SURVEYOR No. 12028 — REGISTERED LAND SURVEYOR

Signed by Carl F. Roser Date 6-08-95

Surveyor's Michigan License No. 12028

FORM APPROVED BY MICHIGAN STATE BOARD OF LAND SURVEYORS, JAN. 26, 1971
REVISED MAY 14, 1975
REVISED JAN., 1983