LAND CORNER RECORDATION CERTIFICATE

Filing Requirement of Act 74, Mich. P.A. 1970

For corners in ROSCOMMON (County)

	Located In:	Corner Code #1
1. Public Land Survey	T 24N R 2W	C-11, B-13
	T ____ R ____	
	T ____ R ____	
	T ____ R ____	
2. Property Controlling	S ____ T ____ R ____	
in Section	S ____ T ____ R ____	
3. Miscellaneous	S ____ T ____ R ____	
Property in Sec.	S ____ T ____ R ____	

Register of Deeds Stamp & File Number

4. Lot No. _____ , Recorded Plat _____
5. Private Claims _____

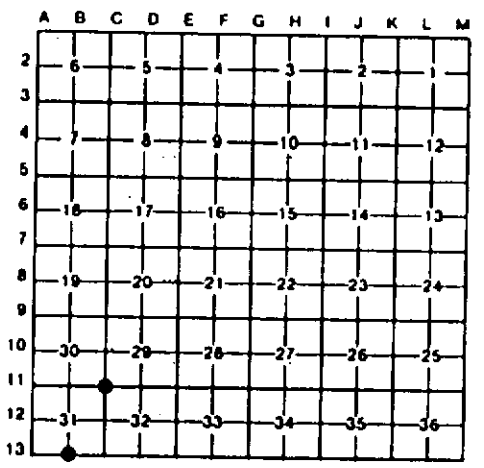

I, C.F.ROSER, in a field survey on MAY 19, 19 95, do hereby certify that under requirements of P.A. 74, Michigan P.A. of 1970, the corner points mentioned in lines 1 and 2 above were in conformance with regulations and rules therefore as required in the current manual of survey instructions of the United States Department of the Interior, Bureau of Land Management or by a decree of a Court of Law and/or that the corner points mentioned in lines 3, 4 and 5 above were in conformance with the rules of the Michigan Board of Land Surveyors or by a Decree of a Court of Law; established, re-established, monumented, re-monumented, recovered, found as expressed below:

NOTE: Not more than 4 corners, all in the same town and range, may be recorded on this certificate.

A. Description of original monument and accessories and/or subsequent restoration:

C-11

B-13

(NO EVIDENCE OF G.L.O. CORNER, B.T'S, LINE TREES & TOPOGRAPHY, AS CALLED OUT IN THE G.L.O. LINE NOTES; UNLESS NOTED IN ITEM "B" BELOW.)

B. Description of corner evidence found and/or method applied in restoring or reestablishing corner:

C-11

FD CONSERVATION DEPT. MON. FOR NW COR OF SEC.32 AS SET BY M.S.H.D. SURVEYOR NORM CALDWELL IN 1966 SURVEY FOR I-75. N.C. FD NBT'S BY G.F.DELAMATER (1929) & 1/2" BAR LYING ON GROUND (N.C. SAID "THIS CHECKS WITH SWAMP EDGES TO EAST & SOUTH AS SHOWN ON ORIG. SURVEY").

B-13

FD. CONS.DEPT MON FOR 1/4 COR COMMON TO SEC. 31(T24N-R2W) & SEC. 6(T23N-R2W). MON WAS SET BY NORM CALDWELL IN 1966 M.S.H.D. SURVEY FOR I-75. N.CALDWELL FD 1 1/4" PIPE IN CONC. (PROBABLY M.SCHAAF MONUMENT) & POST AND SET CONS. DEPT. MON. IN OLD PIPE (BELOW WATER) & NEW 4"x 4" CEDAR POST. N.C. SAID "CORNER IS 225' SOUTH OF CTR. E-W ROAD".

C. Description of monument for corner and accessories established to perpetuate locating the position of the corner:

C-11

FD CONSERVATION. DEPT. MON. w/POST.

14" TW.OAK	S50°W	5.03'
10"-14"QUAD.OAK	N20°W	10.26'
10" TW.CHERRY	S80°E	41.05'
14" TW.MAPLE	S19°E	75.60'

TREES HAVE UPPER BLAZE.

B-13

FD. CONSERVATION DEPT. MON IN MARSH.

NO AVAILABLE WIT'S.

STATE OF MICHIGAN
CARL F. ROSER
LAND SURVEYOR
No. 12028
REGISTERED LAND SURVEYOR

Signed by Carl F. Roser Date 6-08-95

Surveyor's Michigan License No. 12028

FORM APPROVED BY MICHIGAN STATE BOARD OF LAND SURVEYORS, JAN. 28, 1971
REVISED MAY 14, 1975
REVISED JAN., 1983