

**SURVEY &
REMONUMENTATION**

8350

ROSCOMMON COUNTY REMONUMENTATION TO BE FILED IN LIBER 3 OF LAND CORNERS

APR 24 1995 **LAND CORNER RECORDATION CERTIFICATE**
Filing Requirement of Act 74, Mich. P.A. 1970

STATE OF MICHIGAN
ROSCOMMON COUNTY
RECORDED

For corners in

COMMISSION

14 NOV 94 3:07 P.M.

Roscommon <small>(County)</small>	Located In:	Corner Code #
1. Public Land Survey	T22N, R2W	A-11
	T _____ R _____	_____
	T _____ R _____	_____
	T _____ R _____	_____
2. Property Controlling in Section	S _____ T _____ R _____	_____
	S _____ T _____ R _____	_____
3. Miscellaneous Property in Sec.	S _____ T _____ R _____	_____
	S _____ T _____ R _____	_____

ROBERT W. SMITH
REGISTER OF DEEDS
ROSCOMMON COUNTY
PEER GROUP APPROVAL
DATE 10-20-94

MEM

Register of Deeds Stamp & File Number

4. Lot No. _____, Recorded Plat _____
5. Private Claims _____

	A	B	C	D	E	F	G	H	I	J	K	L	M
2	6	5	4	3	2	1							
3													
4	7	8	9	10	11	12							
5													
6	18	17	16	15	14	13							
7													
8	19	20	21	22	23	24							
9													
10	30	29	28	27	26	25							
11													
12	31	32	33	34	35	36							
13													

I, Larry L. Cavanagh, in a field survey on September, 1994, do hereby certify that under requirements of P.A. 74, Michigan P.A. of 1970, the corner points mentioned in lines 1 and 2 above were in conformance with regulations and rules therefore as required in the current manual of survey instructions of the United States Department of the Interior, Bureau of Land Management or by a decree of a Court of Law and/or that the corner points mentioned in lines 3, 4 and 5 above were in conformance with the rules of the Michigan Board of Land Surveyors or by a Decree of a Court of Law; established, re-established, monumented, re-monumented, recovered, found as expressed below:

NOTE: Not more than 4 corners, all in the same town and range, may be recorded on this certificate.

A. Description of original monument and accessories and/or subsequent restoration:

- Post set by John Burt 1838
- Cedar 14" S83°W 17 links
- Birch 9" N36°W 33 links

- 1975 LCRC Ken Ostling Liber 1, Page 107
- Set DNR Monument
- 7" Cedar N46 1/2°E 60.3'
- 6" Twin Cedar S22°E 61.3'
- Face P.Pole S80°W 48.6'

B. Description of corner evidence found and/or method applied in restoring or reestablishing corner:

- No original evidence found
- Found DNR Monument
- Found 7" Cedar NE
- Found P. Pole SW


C. Description of monument for corner and accessories established to perpetuate locating the position of the corner:

- Set 2 1/2" x 24" cast iron Roscommon County Monument
- 17614 - 1994
- S41°E nail and tag in 14" Cedar 39.62'
- N46 1/2°E nail and tag in 8" Cedar 60.53'
- S80°W nail and tag in P. Pole 48.97'
- N12°W Carsonite Post 1.22'

Is accepted as the best available evidence of the position of the original corner.

Signed by Larry L. Cavanagh
Surveyor's Michigan License No. 17614

Date 11/14/94

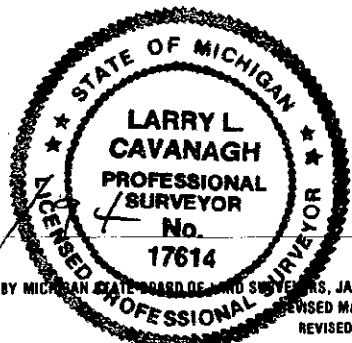

FORM APPROVED BY MICHIGAN STATE BOARD OF LAND SURVEYORS, JAN. 28, 1971
REVISED MAY 14, 1975
REVISED JAN., 1983