

SURVEY & REMONUMENTATION

8355

APR 24 1995

ROSCOMMON COUNTY REMONUMENTATION TO BE FILED IN LIBER 3 OF LAND CORNERS

LAND CORNER RECORDATION CERTIFICATE COMMISSION Filing Requirement of Act 74, Mich. P.A. 1970

STATE OF MICHIGAN
ROSCOMMON COUNTY
RECORDED

For corners in

Roscommon <small>(County)</small>	Located In:	Corner Code #
1. Public Land Survey	T 22N, R 2W	B-7
	T _____ R _____	_____
	T _____ R _____	_____
	T _____ R _____	_____
2. Property Controlling in Section	S _____ T _____ R _____	_____
	S _____ T _____ R _____	_____
3. Miscellaneous Property in Sec.	S _____ T _____ R _____	_____
	S _____ T _____ R _____	_____
4. Lot No. _____, Recorded Plat _____		
5. Private Claims _____		

14 NOV 94 3:07 P.M.

ROBERT W. SMITH
REGISTER OF DEEDS
ROSCOMMON COUNTY
PEER GROUP APPROVAL
DATE 5-10-94
Register of Deeds Stamp & File Number

I, Larry L. Cavanagh, in a field survey on September, 1994, do hereby certify that under requirements of P.A. 74, Michigan P.A. of 1970, the corner points mentioned in lines 1 and 2 above were in conformance with regulations and rules therefore as required in the current manual of survey instructions of the United States Department of the Interior, Bureau of Land Management or by a decree of a Court of Law and/or that the corner points mentioned in lines 3, 4 and 5 above were in conformance with the rules of the Michigan Board of Land Surveyors or by a Decree of a Court of Law; established, re-established, monumented, re-monumented, recovered, found as expressed below:

NOTE: Not more than 4 corners, all in the same town and range, may be recorded on this certificate.

	A	B	C	D	E	F	G	H	I	J	K	L	M
2	6	5	4	3	2								
3													
4	7	8	9	10	11	12							
5													
6	18	17	16	15	14	13							
7													
8	19	20	21	22	23	24							
9													
10	30	29	28	27	26	25							
11													
12	31	32	33	34	35	36							
13													


A. Description of original monument and accessories and/or subsequent restoration:
 Post set by William Burt
 August 1852
 W. Birch 6" N8°E 4 links
 Spruce 7" S44°E 12 links

B. Description of corner evidence found and/or method applied in restoring or reestablishing corner:
 No original evidence was found
 In 1982 John Nelson, P.S. found an old post and reset a concrete monument. Monument found in course of our 1994 survey, also found 2" pipe 32.3 feet East of monument. Neither of these positions fit GLO chainage or swamp ties. Monument set at single proportionate distance between A-7 and C-7.

C. Description of monument for corner and accessories established to perpetuate locating the position of the corner:
 Set Roscommon County Monument 2 1/2" x 24" cast iron, (17614) inside of 3" x 40" pipe
 North 1.0' carsonite post
 S05°W nail and tag in 14" B. Oak
 S65°E nail and tag in 8" W. Pine
 N70°E nail and tag in 14" Tamarac
 Is accepted as the best available evidence of the re-establishment of the original corner.

Signed by Larry L. Cavanagh
 Surveyor's Michigan License No. 17614

Date Nov. 14, 1994

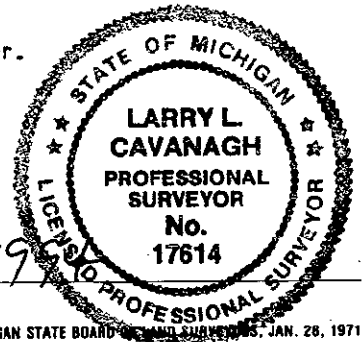

FORM APPROVED BY MICHIGAN STATE BOARD OF LAND SURVEYORS, JAN. 26, 1971
 REVISED MAY 14, 1975
 REVISED JAN., 1983

LIBER 3 PAGE 136