

SURVEY & REMONUMENTATION
8357 ROSCOMMON COUNTY REMONUMENTATION

APR 24 1995 **LAND CORNER RECORDATION CERTIFICATE**
Filing Requirement of Act 74, Mich. P.A. 1970

STATE OF MICHIGAN
 ROSCOMMON COUNTY
 RECORDED

For corners in

COMMISSION

14 NOV 94 3:08 P.M.

<u>Roscommon</u> (County)	Located In:	Corner Code #
1. Public Land Survey	T <u>22N</u> , R <u>2W</u>	<u>C-8</u>
	T _____ R _____	_____
	T _____ R _____	_____
	T _____ R _____	_____
2. Property Controlling in Section	S _____ T _____ R _____	_____
	S _____ T _____ R _____	_____
3. Miscellaneous Property in Sec.	S _____ T _____ R _____	_____
	S _____ T _____ R _____	_____
4. Lot No. _____, Recorded Plat _____		
5. Private Claims _____		

ROBERT W. SMITH
 REGISTER OF DEEDS
ROSCOMMON COUNTY
PEER GROUP APPROVAL
 DATE 10-20-94

TO BE FILED IN LIBER 3 OF LAND CORNERS
 Register of Deeds Stamp & File Number

I, Larry L. Cavanagh, in a field survey on September, 1994, do hereby certify that under requirements of P.A. 74, Michigan P.A. of 1970, the corner points mentioned in lines 1 and 2 above were in conformance with regulations and rules therefore as required in the current manual of survey instructions of the United States Department of the Interior, Bureau of Land Management or by a decree of a Court of Law and/or that the corner points mentioned in lines 3, 4 and 5 above were in conformance with the rules of the Michigan Board of Land Surveyors or by a Decree of a Court of Law; established, re-established, monumented, re-monumented, recovered, found as expressed below:

	A	B	C	D	E	F	G	H	I	J	K	L	M
2	6		5		4		3		2		1		
3													
4	7		8		9		10		11		12		
5													
6	18		17		16		15		14		13		
7													
8	19		20		21		22		23		24		
9													
10	30		29		28		27		26		25		
11													
12	31		32		33		34		35		36		
13													


NOTE: Not more than 4 corners, all in the same town and range, may be recorded on this certificate.

A. Description of original monument and accessories and/or subsequent restoration:
 Post set by William Burt 1852
 Hemlock 12" N73°W 28 links
 Hemlock 24" S50°E 48 links
 DNR notes indicate Schaaf perpetuated corner
 no date

B. Description of corner evidence found and/or method applied in restoring or reestablishing corner:
 No original evidence found
 Found square wood post, not believed to be Schaff's as he usually set pipes cast in concrete base. However, post is 2.5 feet South of mid point and 13.9 feet west of line between C-7 and C-9 and was accepted as best available evidence of the original location.

C. Description of monument for corner and accessories established to perpetuate locating the position of the corner:
 Set 2 1/2" x 24" cast iron Roscommon County Monument
 17614 - 1994
 S55°E nail and tag in 5" W. Pine
 N65°E nail and tag in 7" W. Pine
 N65°W nail and tag in 4" Maple
 S66°W nail and tag in 7" B. Oak
 Carsonite post North 1.05'
 Is-accepted as the best available evidence of the position of the original corner.

Signed by Larry L. Cavanagh Date 11/14/94
 Surveyor's Michigan License No. 17614

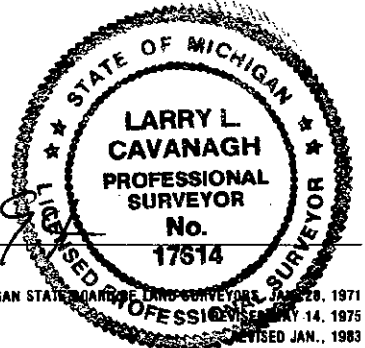

FORM APPROVED BY MICHIGAN STATE BOARD OF LAND SURVEYORS, JAN 20, 1971
 REVISED JAN. 14, 1975
 REVISED JAN., 1983

Date October 20, 1994 Peer Group Approved
LIBER 3 PAGE 138