

**8353 SURVEY & REMONUMENTATION**

ROSCOMMON COUNTY REMONUMENTATION TO BE FILED IN LIBER 3 OF LAND CORNERS

APR 24 1995

**LAND CORNER RECORDATION CERTIFICATE**  
Filing Requirement of Act 74, Mich. P.A. 1970

STATE OF MICHIGAN  
ROSCOMMON COUNTY  
RECORDED

For corners in

**COMMISSION**

14 NOV 94 3:07 P.M.

Roscommon (County) Located In: Corner Code #/

1. Public Land Survey T 22N R 2W C-9  
 T \_\_\_\_\_ R \_\_\_\_\_  
 T \_\_\_\_\_ R \_\_\_\_\_  
 T \_\_\_\_\_ R \_\_\_\_\_

2. Property Controlling S \_\_\_\_\_ T \_\_\_\_\_ R \_\_\_\_\_  
 in Section S \_\_\_\_\_ T \_\_\_\_\_ R \_\_\_\_\_

3. Miscellaneous S \_\_\_\_\_ T \_\_\_\_\_ R \_\_\_\_\_  
 Property in Sec. S \_\_\_\_\_ T \_\_\_\_\_ R \_\_\_\_\_

4. Lot No. \_\_\_\_\_, Recorded Plat \_\_\_\_\_

5. Private Claims \_\_\_\_\_

ROBERT W. SMITH  
REGISTER OF DEEDS  
**ROSCOMMON COUNTY**  
**PEER GROUP APPROVAL**

DATE 10-20-94 *MRM*

Register of Deeds Stamp & File Number

I, Larry L. Cavanagh, in a field survey on September, 19 94, do hereby certify that under requirements of P.A. 74, Michigan P.A. of 1970, the corner points mentioned in lines 1 and 2 above were in conformance with regulations and rules therefore as required in the current manual of survey instructions of the United States Department of the Interior, Bureau of Land Management or by a decree of a Court of Law and/or that the corner points mentioned in lines 3, 4 and 5 above were in conformance with the rules of the Michigan Board of Land Surveyors or by a Decree of a Court of Law, established, re-established, monumented, re-monumented, recovered, found as expressed below:

**NOTE: Not more than 4 corners, all in the same town and range, may be recorded on this certificate.**

**A. Description of original monument and accessories and/or subsequent restoration:**

- Post set by William Burt 1852 1-1/2" pipe set in cement
- W. Pine 24" N80°E 24 links Oak 14" N81°E 47.51'
- Y. Pine 18" S75°E 30 links Oak 12" S58°E 49.85'
- Jack Pine 6" S03°W 18.35'
- Schaaf notes indicate corner reset Tamarack 6" N14°W 31.26'
- original corner Cedar Post North 8.0'
- no date
- 1992 Larry Cavanagh survey in Section 30
- 1990 Carl Johnson found Schaaf Pipe same wit. as Johnson

**B. Description of corner evidence found and/or method applied in restoring or reestablishing corner:**

Schaaf Pipe and Johnson witness found  
No original evidence found.

**C. Description of monument for corner and accessories established to perpetuate locating the position of the corner:**


- Set 2 1/2" x 24" cast iron Roscommon County Monument
- 17614 - 1994
- N81°E nail and tag in 14" Oak 47.51'
- S58°E nail and tag in 12" Oak 49.85'
- S03°E nail and tag in 6" J. Pine 18.35'
- N14°W nail and tag in 6" Tamarack 31.26'
- Cedar post North 8.0'
- Carsonite post North 1.93'

Is accepted as a perpetuation of the original government corner.

Signed by Larry L. Cavanagh

Date \_\_\_\_\_

Surveyor's Michigan License No. 17614

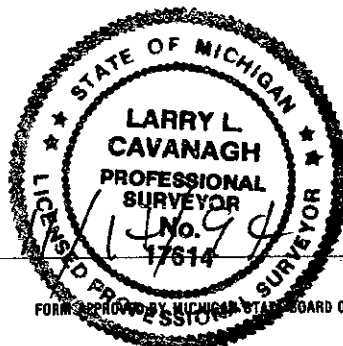

	A	B	C	D	E	F	G	H	I	J	K	L	M
2	6	5	4	3	2	1							
3													
4	7	8	9	10	11	12							
5													
6	18	17	16	15	14	13							
7													
8	19	20	21	22	23	24							
9													
10	30	29	28	27	26	25							
11													
12	31	32	33	34	35	36							
13													