

SURVEY & REMONUMENTATION

APR 07 1998

SECTION

9249

LAND CORNER RECORDATION CERTIFICATE  
Filing Requirement of Act 74, Mich P.A. 1970

STATE OF MICHIGAN  
ROSCOMMON COUNTY  
RECORDED

16 DEC 97 12:27 P.M.

ROBERT W. SMITH  
REGISTER OF DEEDS

For corners in  
Roscommon County

Located in: Corner Code #


I. Public Land Survey

T22N	R 2W	G-7
T	R	
T	R	
T	R	

FILE IN LIBER 3 OF LAND CORNER

Register of Deeds Stamp & File Number

I, Larry L. Cavanagh, in a field survey October, 1997, do hereby certify that under requirements of P.A. 74, Michigan P.A. of 1970, the corner points mentioned in line 1 above was in conformance with regulations and rules therefore as required in the current manual of survey instructions of the United States Department of the Interior, Bureau of Land Management or by a decree of a Court of Law; established, re-established, monumented, recovered, found as expressed below:

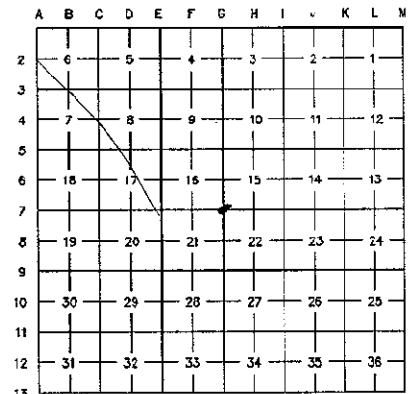

A. Description of original monument and accessories and/or subsequent restoration:

WILLIAM BURT 1852  
SET POST  
W. BIRCH 8" N89E 3 LKS  
CEDAR 6" S51W 11 LKS

M SCHAAF 1930'S  
FD BUT NOT REPLACED

B. Description of corner evidence found and/or method applied in restoring or reestablishing corner:

NO EVIDENCE FOUND  
SET AT SINGLE PROPORTIONATE DISTANT BETWEEN E-7 (N89°09'09"W 5280.94) AND H-7 (S89°09'09"E 2640.46)

C. Description of monument for corner and accessories established to perpetuate locating the position of the corner:

SET ROSCOMMON COUNTY MONUMENT STAMPED 17614, 1997  
SPIKE N12°E 11.93'  
CARSONITE POST WEST 1.05'  
E-7 N89°09'09"W 2640.47'  
H-7 S89°09'09"E 2640.46'  
(NO OTHER WITNESSES AVAILABLE)

A CAREFUL AND FAITHFUL ESTABLISHMENT OF THE POSITION OF THE CORNER.

ROSCOMMON COUNTY  
PEER GROUP APPROVAL  
DATE Dec 5, 1997

Marvin E. Myers, P.S.  
County Surveyor



Signed by *Larry L. Cavanagh*  
Surveyor's Michigan License NO. 17614

Date Dec. 11, 1997