

**SURVEY &
REMONUMENTATION**

APR 07 1998

9248 SECTION

LAND CORNER RECORDATION CERTIFICATE
Filing Requirement of Act 74, Mich P.A. 1970

STATE OF MICHIGAN
ROSCOMMON COUNTY
RECORDED

16 DEC 97 12:27 P.M.

ROBERT W. SMITH
REGISTER OF DEEDS

For corners in
Roscommon County

1. Public Land Survey

Located in:	Corner Code #
T22N R 2W	1-7
T _____	_____
T _____	_____
T _____	_____

FILE IN LIBER 3 OF LAND CORNER:

Register of Deeds Stamp & File Number

I, Larry L. Cavanagh, in a field survey October, 1997, do hereby certify that under requirements of P.A. 74, Michigan P.A. of 1970, the corner points mentioned in line 1 above was in conformance with regulations and rules therefore as required in the current manual of survey instructions of the United States Department of the Interior, Bureau of Land Management or by a decree of a Court of Law; established, re-established, monumented, recovered, found as expressed below:

	A	B	C	D	E	F	G	H	I	J	K	L	M
2	6	5	4	3	2	1							
3													
4	7	8	9	10	11	12							
5													
6	18	17	16	15	14	13							
7													
8	18	20	21	22	23	24							
9													
10	30	29	28	27	26	25							
11													
12	31	32	33	34	35	36							
13													

A. Description of original monument and accessories and/or subsequent restoration:

WILLIAM BURT 1852
SET POST
W. PINE 10 S50E 33 LKS
MAPLE 6 N34W 14 LKS

M SCHIAAF 1930'S
CORNER FD, BUT NOT REPLACED

GF DALAMATER 1937
FD BOTH GOV B'S
W. PINE 5 N19E 17.8'
CEDAR POST IN COR

NORMAN C CALDWELL RLS 12018 1963
FD 1 1/4" PIPE & SCRIBED 3"X3" POST
5" MAPLE S10°E 83.93'
4" BALSAM S25°E 24.35'
6" N. PINE N30°E 121.32'
14" OAK N18°W 18.66'

LCRC L2 P193 1970'S
1 1/4" PIPE 3"X3" POST
SAME WITNESSES AS
HENNING, 1965

GEO. D. HENNING 1965
FD 1 1/4" PIPE & POST
ORIG US B.T. S50°E 22 GOOD
11" BALSAM S85°E 84.35'
4" NORWAY N30°E 121.30'
14" OAK N15°W 18.7'
5" MAPLE S10°E 83.9'

B. Description of corner evidence found and/or method applied in restoring or reestablishing corner:

FOUND 1 1/4" X 48" PIPE WITH CONCRETE BASE
14" OAK N15°W 18.7'


C. Description of monument for corner and accessories established to perpetuate locating the position of the corner:

SET ROSCOMMON COUNTY MONUMENT STAMPED 17614, 1997
NAIL & TAG IN 18" OAK N15°W 18.02'
NAIL & TAG IN 5" BALSAM N64°W 9.75'
NAIL & TAG IN 8" MAPLE N80°E 24.83'
NAIL & TAG IN 3" MAPLE S20°W 24.15'
CARSONITE POST NORTH 1.85'

A PERPETUATION OF THE ORIGINAL GOVERNMENT CORNER.

**ROSCOMMON COUNTY
PEER GROUP APPROVAL
DATE DEC 5 1997**

Marvin E. Myers
Marvin E. Myers, P.S.
County Surveyor

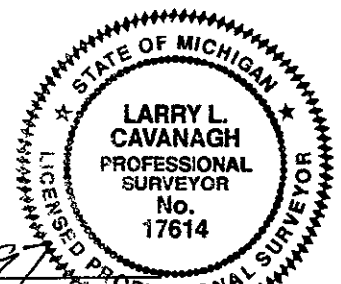

Signed by Larry L. Cavanagh Date Dec. 11, 1997
Surveyor's Michigan License NO. 17614

FORM APPROVED BY MICHIGAN STATE BOARD OF LAND SURVEYORS, JAN 28, 1971
REVISED MAY 14, 1975
REVISED JAN., 1983

LIBER 3 PAGE 473