

**SURVEY &
REMONUMENTATION**

MAY 28 1997

COMMISSION

4728

LAND CORNER RECORDATION CERTIFICATE
Filing Requirement of Act 74, Mich. P.A. 1970

For corners in <u>Roscommon</u> (County)	Located In:	Corner Code #
1. Public Land Survey	T <u>22N</u> R <u>2W</u>	<u>K - 9</u>
	T _____ R _____	_____
	T _____ R _____	_____
	T _____ R _____	_____
2. Property Controlling in Section	S _____ T _____ R _____	_____
	S _____ T _____ R _____	_____
3. Miscellaneous Property in Section	S _____ T _____ R _____	_____
	S _____ T _____ R _____	_____
4. Lot No. _____, Recorded Plat _____		
5. Private Claims _____		

STATE OF MICHIGAN
ROSCOMMON COUNTY
RECORDED

11 JUL 96 11:28 A.M.

ROBERT W. SMITH
REGISTER OF DEEDS

**TO BE FILED IN LIBER 3 OF LAND CORNER
Register of Deeds Stamp & File Number**

A	B	C	D	E	F	G	H	I	J	K	L	M
2	6	5	4	3	2	1						
3												
4	7	8	9	10	11	12						
5												
6	18	17	16	15	14	13						
7												
8	19	20	21	22	23	24						
9												
10	30	29	28	27	26	25						
11												
12	31	32	33	34	35	36						
13												

I, Marvin E. Myers, in a field survey on June 18, 1996, do hereby certify that under requirements of P.A. 74, Michigan P.A. of 1970, the corner points mentioned in lines 1 and 2 above were in conformance with regulations and rules therefore as required in the current manual of survey instructions of the United States Department of the Interior, Bureau of Land Management or by a decree of a Court of Law and/or that the corner points mentioned in lines 3, 4 and 5 above were in conformance with the rules of the Michigan Board of Professional Surveyors or by a Decree of a Court of Law; established, re-established, monumented, re-monumented, recovered, found as expressed below:


NOTE: Not more than 4 corners, all in the same town and range, may be recorded on this certificate.

A. Description of original monument and accessories and/or subsequent restoration:
GLO - Aug 1852 W. Burt
Mon - Post
Wit - 14" Y. Pine S53°W 2 Lks
14" Y. Pine S31°E 28 Lks

B. Description of corner evidence found and/or method applied in restoring or reestablishing corner:
Found 1/2" bar in Center E-W Trail Road & found a 2nd 1/2" bar N84°W 63.15
Accepted as the best available evidence of the position of the original corner.
Replaced 1/2" bar with standard monument.

**ROSCOMMON COUNTY
PEER GROUP APPROVAL
DATE Jan 17, 1996**
Marvin E. Myers
**Marvin E. Myers, P.S.
County Surveyor**

C. Description of monument for corner and accessories established to perpetuate locating the position of the corner:
Mon. - Replaced 1/2" bar with standard Roscommon County Monument stamped "MEM 31600 K-9"
WIT: Found nail NE side 8" B.Oak S46°E 46.45'
Found nail NW side 5" B.Oak S66°W 105.50'
Found nail SW side 18" W.Oak N55°W 109.95'
Found nail E. side 7" Poplar N24°E 40.10'
Carsonite post South 33'±
1/2" bar N84°W 63.15'

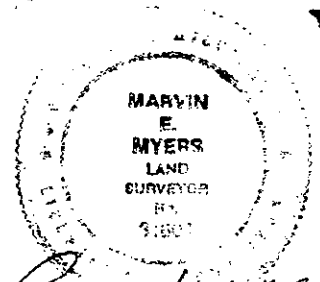

Signed by *Marvin E. Myers* Date *July 17, 1996*
Surveyor's Michigan License No. 31600

1. ... 2. ... 3. ...