

**SURVEY & REMONUMENTATION**

APR 07 1998

SECTION  
9238

**LAND CORNER RECORDATION CERTIFICATE**  
Filing Requirement of Act 74, Mich P.A. 1970

STATE OF MICHIGAN  
ROSCOMMON COUNTY  
RECORDED

16 DEC 97 12:24 P.M.

For corners in  
Roscommon County

Located in: Corner Code #

1. Public Land Survey	T23N R1W	A-13
	T23N R2W	M-13
	T22N R1W	A-1
	T22N R2W	M-1 ✓

ROBERT W. SMITH  
REGISTER OF DEEDS

I, Larry L. Cavanagh, in a field survey November, 1997, do hereby certify that under requirements of P.A. 74, Michigan P.A. of 1970, the corner points mentioned in line 1 above was in conformance with regulations and rules therefore as required in the current manual of survey instructions of the United States Department of the Interior, Bureau of Land Management or by a decree of a Court of Law; established, re-established, monumented, recovered, found as expressed below:

**FILE IN LIBER 3 OF LAND CORNERS**  
Register of Deeds Stamp & File Number

**A. Description of original monument and accessories and/or subsequent restoration:**

JOHN BRINK 1838  
SET POST  
ASPEN 6" N49W 14 LKS  
ASPEN 8" N31E 9 LKS

J.C. LISTER 1958  
RECORDED CAMERON PLAT  
THIS PLAT WAS FOUND TO BE  
STAKED ERRONEOUSLY BY  
ROSER IN 1966 AND WAS NOT  
USED IN EVIDENCE OF CORNER.

C.F. ROSER 12028 1966  
FD 1 1/2" PIPE IN CONC. (18" DEEP)  
THIS CORNER WAS FD IN 1935 BY  
THE CONSERVATION DEPT. AND  
IS A MATTER OF RECORD. THE  
CORNER WAS FD IN A SURVEY  
OF SEC'S 1 AND 2 (T22N, R2W) BY  
J. RICHARDSON IN 1938 AND HE  
HAS THE FIELD NOTES IN HIS  
POSSESSION. THE POINT FALLS  
IN THE APPROX. CTR BIT RD.  
(CO RD 500)  
26" W FINE N34E 85.52'  
30" W. PINE S26E 88.21'  
12" BALSAM S70W 48.77'  
6" W. PINE N54W 46.17'

1970'S L2 P149  
1 1/2" PIPE IN CONC.  
(18" DEEP)  
APPROX. CENTER-  
LINE OF F-97  
N34°E 85.52' 26" W. PINE  
S26°E 88.21' 30" W. PINE  
S70°W 48.77' 12"  
BALSAM  
N54°W 46.17' 6" W. PINE  
  
TIMOTHY L. LAPHAM  
27595 1989 L556 P591  
1 1/2" PIPE IN CENTER-  
LINE OF RD.  
WITNESSES OF RECORD

	A	B	C	D	E	F	G	H	I	J	K	L	M
2	6	5							3		2		1
3													
4	7	8							10		11		12
5													
6	18	17							15		14		13
7													
8	19	20							22		23		24
9													
10	30	29							27		26		25
11													
12	31	32							34		35		36
13													

LARRY L. CAVANAGH 17164 1994  
5" MAPLE S60°W 6.80'  
7" CEDAR N5°W 10.74'  
9" CEDAR S75°E 15.62'

**B. Description of corner evidence found and/or method applied in restoring or reestablishing corner:**

FOUND 1" X 2" FORMING PIN OVER 1 1/4" PIPE  
30" W. PINE S26°E (NOW 34")  
26" W. PINE N34°E (DEAD)


**C. Description of monument for corner and accessories established to perpetuate locating the position of the corner:**

SET ROSCOMMON COUNTY MONUMENT STAMPED 17614, 1997  
NAIL & TAG IN 11" MAPLE N58°W 65.74'  
NAIL & TAG IN 26" W. PINE (DEAD) N26°E 84.91'  
NAIL & TAG IN 6" MAPLE N316E 67.22'  
NAIL & TAG IN 34" W. PINE S26°E 88.52'  
NAIL & TAG IN 11" W. PINE S67°W 60.99'  
CARSONITE POST EAST 23.00'

THE BEST AVAILABLE EVIDENCE OF THE POSITION OF THE ORIGINAL CORNER.

**ROSCOMMON COUNTY  
PEER GROUP APPROVAL  
DATE Dec 5, 1997**

*Marvin E. Myers*  
Marvin E. Myers, P.S.  
County Surveyor

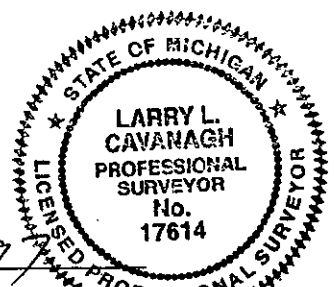

Signed by *Larry L. Cavanagh*  
Surveyor's Michigan License NO. 17614

Date Dec 14, 1997

FORM APPROVED BY MICHIGAN STATE BOARD OF LAND SURVEYORS, JANUARY 28, 1971  
REVISED MAY 14, 1975  
REVISED JAN., 1983

LIBER 3 PAGE 463