

**SURVEY &  
REMONUMENTATION**

MAY 28 1997

COMMISSION

4731

**LAND CORNER RECORDATION CERTIFICATE**  
Filing Requirement of Act 74, Mich. P.A. 1970

For corners in <u>Roscommon</u> (County)	Located In:	Corner Code #
1. Public Land Survey	T <u>22N</u> R <u>2W</u>	M - 8
	T _____ R _____	_____
	T _____ R _____	_____
	T _____ R _____	_____
2. Property Controlling in Section	S _____ T _____ R _____	_____
	S _____ T _____ R _____	_____
3. Miscellaneous Property in Section	S _____ T _____ R _____	_____
	S _____ T _____ R _____	_____
4. Lot No. _____, Recorded Plat _____		
5. Private Claims _____		

STATE OF MICHIGAN  
ROSCOMMON COUNTY  
RECORDED

11 JUL 96 11:29 A.M.

ROBERT W. SMITH  
REGISTER OF DEEDS

**TO BE FILED IN LIBER 3 OF LAND CORNER**  
Register of Deeds Stamp & File Number

I, Marvin E. Myers, in a field survey on June 18, 19 96, do hereby certify that under requirements of P.A. 74, Michigan P.A. of 1970, the corner points mentioned in lines 1 and 2 above were in conformance with regulations and rules therefore as required in the current manual of survey instructions of the United States Department of the Interior, Bureau of Land Management or by a decree of a Court of Law and/or that the corner points mentioned in lines 3, 4 and 5 above were in conformance with the rules of the Michigan Board of Professional Surveyors or by a Decree of a Court of Law; established, re-established, monumented, re-monumented, recovered, found as expressed below:

A	B	C	D	E	F	G	H	I	J	K	L	M
2	6	5	4	3	2	1						
3												
4	7	8	9	10	11	12						
5												
6	18	17	16	15	14	13						
7												
8	19	20	21	22	23	24						
9												
10	30	29	28	27	26	25						
11												
12	31	32	33	34	35	36						
13												

**NOTE: Not more than 4 corners, all in the same town and range, may be recorded on this certificate.**

**A. Description of original monument and accessories and/or subsequent restoration:**

GLO - Nov 2, 1939 J. Brinks Mon - Post Wit - 10" Hemlock N42°W 17 Lks 8" Cedar S39°W 18 Lks	Old Field Notes (Date Unknown) ( Possible Delamater) Mon - 1 1/2" Pipe (Set 1/2" bar added to Old Notes) 7' E. of C Wit - 8" Aspen S69°E 44.5 10" Aspen N53°E 73.5 Marked New 4" Maple N45°E 61.9 Marked New 8" Maple S76°E 45.0	L. 297, P. 211 Sept 1974 L.L. Cavanagh Mon - Found 1/2" bar Wit - 4" Maple N45°E 61.9 8" Maple S76°E 45.0 12" Aspen S69°E 44.5 14" Aspen N53°E 73.5 L.332, P. 149 May 31, 1977 G.D. Henning Mon - Found 1/2" bar Wit - 4" Maple N43°E 61.9 8" Maple S76°E 45.0
--	---	---

**B. Description of corner evidence found and/or method applied in restoring or reestablishing corner:**

Found 1/2" bar 7' East of centerline N-S road. Found 1/2" bar & cap 40.00' West, on Right of Way. Accepted as the best available evidence of the position of the original corner. Replaced with standard Roscommon county monument.

**ROSCOMMON COUNTY  
PEER GROUP APPROVAL**


DATE June 17, 1996

*Marvin E. Myers*

**Marvin E. Myers, P.S.  
County Surveyor**

**C. Description of monument for corner and accessories established to perpetuate locating the position of the corner:**

Mon.- Replaced 1/2"x12" bar with standard Roscommon County Monument and pavement box  
WIT: Set nail S. side 10" W.Pine N75°W 83.36'  
Set nail NW side 12" R.Pine S37°W 76.78'  
Set nail S. side 4" B.Oak S86°E 28.86'  
Set nail NW side 8" B.Oak N41°E 47.47'

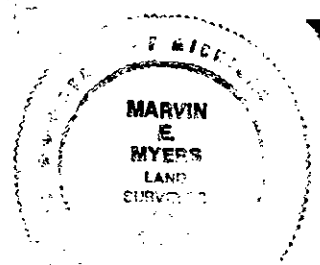

Signed by *Marvin E. Myers*

Date June 24, 1996

Surveyor's Michigan License No. 31600

1 - 2 D. - 2.1