

# LAND CORNER RECORDATION CERTIFICATE

## FILING REQUIREMENT OF ACT 74, MICH. P.A.1970

| FOR CORNERS OF—:                             | LOCATED IN—:   | CORNER CODE NUMBER |
|--|--|--------------------|
| 1. PUBLIC LAND SURVEY _____                  | T. 22 <span style="display: inline-block; width: 10px; height: 10px; border: 1px solid black; border-radius: 50%;"></span> N. R. 3 <span style="display: inline-block; width: 10px; height: 10px; border: 1px solid black; border-radius: 50%;"></span> W. | L-13; M-13         |
| 2. PROPERTY CONTROLLING IN SECTION <u>36</u> | T. 22 <span style="display: inline-block; width: 10px; height: 10px; border: 1px solid black; border-radius: 50%;"></span> N. R. 3 <span style="display: inline-block; width: 10px; height: 10px; border: 1px solid black; border-radius: 50%;"></span> W. | 15; 16             |
| 3. MISCELLANEOUS PROPERTY IN SECTION _____   | T. _____ S. R. _____ E. W.   | _____              |
| 4. LOT NO. _____, RECORDED PLAT _____        |  |                    |
| 5. PRIVATE CLAIMS _____                      |  |                    |

REGISTER OF DEEDS STAMP AND FILING NUMBER

I, Kenneth J. Ostling do hereby certify that under requirements of P.A. 74, Michigan P.A. of 1970, the corner points mentioned in lines 1 and 2 above (identified with circles on index code diagram—over) were, in a field survey on October 2, 1974, established, re-established, monumented, re-monumented, recovered or restored as expressed below and in conformance with regulations and rules therefore as required in the current manual of survey instructions of the United States Department of the Interior, Bureau of Land Management or by a decree of a court of law. Furthermore, that the corner points mentioned in lines 3, 4 and 5 above were, in a field survey on \_\_\_\_\_ 19\_\_\_\_, found, recovered, restored, established or re-established as expressed below and in conformance with the rules of the Michigan State Board of Registration for Land Surveyors or, by a Decree of a Court of law:


A. Description of original monument and accessories and/or subsequent restoration:

B. Description of corner evidence found and/or method applied in restoring or re-establishing corner:

- L-13 Found properly established at midpoint on line between section corners.
- M-13 Set in line and equidistant from corners west. Previous corner probably removed in pipeline construction.
- 15 Found properly established.
- 16 Found properly established.

C. Description of monument for corner and accessories established to perpetuate locating the position of the corner:

| L-13                  | M-13                             | 15                               |
|-----------------------|----------------------------------|----------------------------------|
| Left 2" pipe in place | Set 3/4"x36" iron bar            | Left 1" pipe/conc. base in place |
| 5" R. Pine S64°E 50.4 | N-S power line West 56.5         | 5" R. Pine N49°W 49.9            |
| 6" R. Pine S40°W 19.6 | 9" Cedar N85°E 34.6              | 6" R. Pine S60°W 31.4            |
|                       | 30" W. Pine N35°E 52.9           |                                  |
|                       | 16                               |                                  |
|                       | Left 1" pipe/conc. base in place |                                  |
|                       | 9" J. Pine N47°W 39.8            |                                  |
|                       | 10" B. Oak N35°E 26.5            |                                  |

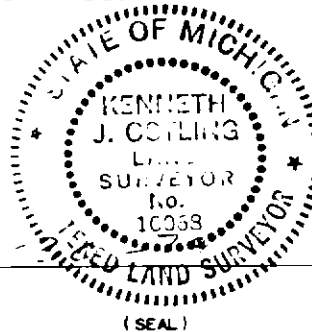

SIGNED BY *Kenneth J. Ostling* DATE 12  
 SURVEYOR'S MICHIGAN REGISTRATION NO. 10068

FOR STATE AND UNITED STATES AGENCIES:

SIGNED BY \_\_\_\_\_ DATE \_\_\_\_\_  
CHIEF OF SURVEY PARTY  
 APPROVED AND SIGNED BY \_\_\_\_\_ DATE \_\_\_\_\_  
MICHIGAN REGISTERED LAND SURVEYOR

SURVEYOR'S MICHIGAN REGISTRATION NO. \_\_\_\_\_ ROSCOMMON COUNTY