

Surveying Territory

LAND CORNER RECORDATION CERTIFICATE

FILING REQUIREMENT OF ACT 74, MICH. P.A.1970

FOR CORNERS OF--:	LOCATED IN--:	CORNER CODE NUMBER
1. PUBLIC LAND SURVEY	T. 22 ^{N.} R. 3 ^{W.}	M-11; M-12
2. PROPERTY CONTROLLING IN SECTION 36	T. 22 ^{N.} R. 3 ^{W.}	7
3. MISCELLANEOUS PROPERTY IN SECTION	T. _____ ^{N.} R. _____ ^{E.}	
4. LOT NO. _____	RECORDED PLAT _____	
5. PRIVATE CLAIMS _____		

REGISTER OF DEEDS STAMP AND FILING NUMBER

I, Kenneth J. Ostling do hereby certify that under requirements of P.A. 74, Michigan P.A. of 1970, the corner points mentioned in lines 1 and 2 above (identified with circles on index code diagram - over) were, in a field survey on November 22, 1974, established, re-established, monumented, re-monumented, recovered or restored as expressed below and in conformance with regulations and rules therefore as required in the current manual of survey instructions of the United States Department of the Interior, Bureau of Land Management or by a decree of a court of law. Furthermore, that the corner points mentioned in lines 3, 4 and 5 above were, in a field survey on _____ 19____, found, recovered, restored, established or re-established as expressed below and in conformance with the rules of the Michigan State Board of Registration for Land Surveyors or, by a Decree of a Court of law:


A. Description of original monument and accessories and/or subsequent restoration:

B. Description of corner evidence found and/or method applied in restoring or re-establishing corner:

- M-11 Set corner on line and double distance over 1/8 and 1/4 corners north. Corner apparently destroyed in pipeline construction.
- M-12 Set corner on line and double distance over 1/8 and section corner south. Falls in marsh, no other corner evident.
- 7 Set by standard survey procedure for subdivision of sections.

C. Description of monument for corner and accessories established to perpetuate locating the position of the corner:

M-11	M-12	7
Set DNR monument	Set 1" pipe	Set 1/2"x36" iron bar
7" cedar N46 1/2°E 60.3	5" W. Pine N61°W 12.6	5" W. Pine N76°W 50.0
6" Twn.cedar S22°E 61.3	6" W. Pine N88°E 58.3	5" W. Pine N101°W 10.1
Face P.P. S80°W 48.6		

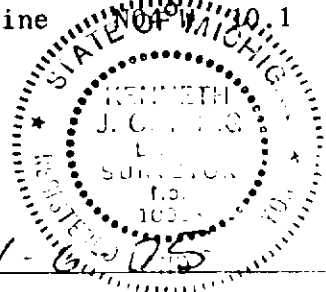

SIGNED BY *Kenneth J. Ostling* DATE 1-6-75
 SURVEYOR'S MICHIGAN REGISTRATION NO. 10068 (SEAL)

FOR STATE AND UNITED STATES AGENCIES:
 SIGNED BY _____ DATE _____
CHIEF OF SURVEY PARTY
 APPROVED AND SIGNED BY _____ DATE _____
MICHIGAN REGISTERED LAND SURVEYOR (SEAL)