

**SURVEY &
REMONUMENTATION**

9160

MAY 28 1997

**ROSCOMMON COUNTY REMONUMENTATION
LAND CORNER RECORDATION CERTIFICATE
Filing Requirement of Act 74, Mich. P.A. 1970**

COMMISSION
STATE OF MICHIGAN
ROSCOMMON COUNTY
RECORDED

6 DEC 96 4:25 P.M.

ROBERT W. SMITH
REGISTER OF DEEDS

For corners in

ROSCOMMON (County)	Located In:	Corner Code #
1. Public Land Survey	T 22N R 4W T 22N R 3W T R T R	M - 13 A-13
2. Property Controlling in Section	S T R S T R	
3. Miscellaneous Property in Sec.	S T R S T R	
4. Lot No. _____, Recorded Plat _____		
5. Private Claims _____		

TO BE FILED IN LIBER 3 OF LAND CORNERS
Register of Deeds Stamp & File Number

I, TIMOTHY L. LAPHAM, in a field survey on July, 9 19 96 do hereby state that under requirements of P.A. 74, Michigan P.A. of 1970, the corner points mentioned in lines 1 and 2 above were in conformance with regulations and rules therefore as required in the current manual of survey instructions of the United States Department of the Interior, Bureau of Land Management or by a decree of a Court of Law and/or that the corner points mentioned in lines 3, 4 and 5 above were in conformance with the rules of the Michigan Board of Land Surveyors or by a Decree of a Court of Law; established, re-established, monumented, recovered, found as expressed below:

A-1 T21N R3W
M-1 T21N R4W

NOTE: Not more than 2 corners, all in the same town and range, may be recorded on this certificate.

A. Description of original monument and accessories and/or subsequent restoration:

M -13 GLO BRINK 1836, POST, 8" BALSAM S68W 12 LINKS, 14" TAMRACK S54E 23 LINKS; SURVEY, OSTLING (REC 249-665, 5/27/1971), NO CORNER MATERIAL, NO WITS;

B. Description of corner evidence found and/or method applied in restoring or reestablishing corner:


M -13 NO EVIDENCE OF GLO FOUND. FOUND 1/2" IRON. DISTANCES NORTH TO M-12 AND M-11 IN AGREEMENT WITH OSTLING SURVEY. ACCEPTED FOUND MONUMENT AS BEST EVIDENCE OF POSITION OF ORIGINAL CORNER. SEE DOSSIER FOR ADDITIONAL INFORMATION.

**ROSCOMMON COUNTY
PEER GROUP APPROVAL
DATE AUG 16 1996**

Marvin E. Myers
**Marvin E. Myers, P.S.
County Surveyor**

C. Description of monument for corner and accessories established to perpetuate locating the position of the corner:

M -13 SET 2" X 21" CAST IRON MONUMENT WITH BRASS ROSCOMMON COUNTY PLATE IN MONUMENT BOX.
S89E 21.04' 12" CEDAR, NAIL IN NORTH SIDE OF TREE
S36W 17.49' 12" CEDAR, NAIL IN EAST SIDE OF TREE
N84W 15.58' 6" HEMLOCK, NAIL IN SOUTH SIDE OF TREE
N27W 4.97' 5" HEMLOCK, NAIL IN SE SIDE OF TREE

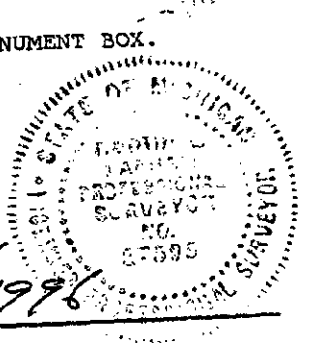

Signed by *T. Lapham*
Surveyor's Michigan License No. 27595

Date 10/01/1996