

**SURVEY &  
REMONUMENTATION**

APR 07 1998

9202 SECTION

**LAND CORNER RECORDATION CERTIFICATE  
Filing Requirement of Act 74, Mich. P.A. 1970**

For corners in

<u>Roscommon</u> (County)	Located In:	Corner Code #
1. Public Land Survey	T 22NR 3W	C-9
	T _____ R _____	_____
	T _____ R _____	_____
	T _____ R _____	_____
2. Property Controlling in Section	S _____ T _____ R _____	_____
	S _____ T _____ R _____	_____
3. Miscellaneous Property in Sec.	S _____ T _____ R _____	_____
	S _____ T _____ R _____	_____

STATE OF MICHIGAN  
ROSCOMMON COUNTY  
RECORDED

16 DEC 97 10:10 A.M.

ROBERT W. SMITH  
REGISTER OF DEEDS

FILE IN LIBER 3 OF LAND CORNERS

Register of Deeds Stamp & File  
Number

4. Lot No. \_\_\_\_\_, Recorded Plat \_\_\_\_\_  
5. Private Claims \_\_\_\_\_

I, Marvin E. Myers, in a field survey on September 5, 1997 do hereby state that under requirements of P.A. 74, Michigan P.A. of 1970, the corner points mentioned in lines 1 and 2 above were in conformance with regulations and rules therefore as required in the current manual of survey instructions of the United States Department of the Interior, Bureau of Land Management or by a decree of a Court of Law and /or that the corner points mentioned in lines 3, 4 and 5 above were in conformance with the rules of the Michigan Board of Land Surveyors or by a Decree of a Court of Law; established, re-established, monumented, recovered, found as expressed below:

**NOTE: Not more than 2 corners, all in the same town and range, may be recorded on this certificate.**

A. Description of original monument and accessories and/or subsequent restoration:

G.L.O. 1849  
William A. Burt, D.S.  
Mon: Maple Post  
Wit: 16" Yellow Pine S62° E 20 links  
20" White Pine N55° W 5 links

Liber 2, Page 234  
Mon: 1/2" Iron rod in Mon. Box  
Wit: Telephone Pole N45°W 45.42  
Power Pole N45°E 42.66'  
16" Maple S50°E 79.54'

Larry L. Cavanagh, R.L.S. 17614  
L. 352, P. 504, 31, August 1978  
Mon: No description provided  
Wit: 14" Oak N40°W 67.50'  
Telephone Pole N40°E 42.5  
Telephone Pole S40°W 46.00

Robert T. Ostling R.L.S. #5133  
Unrecorded Survey August 12, 1964  
Mon: Pipe in cor. - place 12" spike  
to surface.  
Wit: 10" Maple S56°E 79.1'  
Corner is 2.65 East of  
constructed centerline

Larry L. Cavanagh, R.L.S. #17614  
L. 1, P. 124, 18, January 1979  
Mon: Pav't Mon Box  
Wit: 14" Oak N40°W 67.50'  
Telephone Pole N40°E 42.5'  
Telephone Pole S40°W 46.0'

	A	B	C	D	E	F	G	H	I	J	K	L	M
1													
2	6		5		4		3		2		1		
3													
4	7		8		9		10		11		12		
5													
6	18		17		16		15		14		13		
7													
8	19		20		21		22		23		24		
9													
10	30		29		28		27		26		25		
11													
12	31		32		33		34		35		36		
13													

C. Eugene Ostling R.L.S. # 12026  
Unrecord Survey 7, August 1968  
Mon: No description provided  
Wit: No witnesses provided

Larry L. Cavanagh, R.L.S. #17614  
L. 1, P. 191, 19 January 1980  
Mon: Corner in pav't box  
Wit: 14" Oak N40°W 67.50'  
Telephone Pole N40°E 42.5'  
Telephone Pole S40°W 46.0'

B. Description of corner evidence found and/or method applied in restoring or reestablishing corner:

Found Spike in water valve box. Found spike in Guy Pole S45°W 47.2': Found Nail and tag in Power Pole N47°E 42.68': Found 24" Maple S48°E 42.68': Found 25" Oak N45°W 66.80'  
Accepted spike as the best available evidence of the position of the Original Government corner.  
Replaced spike with Standard Roscommon County monument placed in new standard pavement box.


C. Description of monument for corner and accessories established to perpetuate locating the position of the corner:

Mon - Standard Roscommon County Monument in Pavement box.  
Wit: Nail & tag in SE side Power Pole N47°E 73.23'  
Set Nail & tag in NE side 24" Red Oak N42°W 42.68'  
Set Nail & tag in NW side 20" White Pine S31°W 81.21'  
Nail & tag in SW side " Camp Co-Be-Ac" Sign S35°E 65.35'

**ROSCOMMON COUNTY  
PEER GROUP APPROVAL  
DATE Dec 5, 1997**

*Marvin E. Myers*  
Marvin E. Myers, P.S.  
County Surveyor

Signed by *Marvin E. Myers*  
Surveyor's Michigan License No. 31600

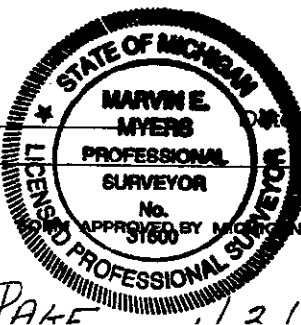

Dec 8, 1997

LIBER 3 PAGE 121