

# SURVEY & REMONUMENTATION

8337

APR 24 1995

ROSCOMMON COUNTY REMONUMENTATION TO BE FILED IN LIBER 3 OF LAND

CORNERS

## LAND CORNER RECORDATION CERTIFICATE

STATE OF MICHIGAN  
ROSCOMMON COUNTY  
RECORDED

### COMMISSION Filing Requirement of Act 74, Mich. P.A. 1970

For corners in

Roscommon	Located In:	Corner Code <i>##</i>
(County)		
1. Public Land Survey	T <u>22N</u> R <u>3W</u>	<u>D-7</u>
	T _____ R _____	_____
	T _____ R _____	_____
	T _____ R _____	_____
2. Property Controlling in Section	S _____ T _____ R _____	_____
	S _____ T _____ R _____	_____
3. Miscellaneous Property in Sec.	S _____ T _____ R _____	_____
	S _____ T _____ R _____	_____
4. Lot No. _____, Recorded Plat _____		
5. Private Claims _____		

14 NOV 94 3:04 P.M.

ROBERT W. SMITH  
REGISTERED AS DEEDS

**ROSCOMMON COUNTY**  
**PEER GROUP APPROVAL** *MEV*  
**DATE** 11-10-94

Register of Deeds Stamp & File Number

I, Larry L. Cavanagh, in a field survey on October, 1994, do hereby certify that under requirements of P.A. 74, Michigan P.A. of 1970, the corner points mentioned in lines 1 and 2 above were in conformance with regulations and rules therefore as required in the current manual of survey instructions of the United States Department of the Interior, Bureau of Land Management or by a decree of a Court of Law and/or that the corner points mentioned in lines 3, 4 and 5 above were in conformance with the rules of the Michigan Board of Land Surveyors or by a Decree of a Court of Law; established, re-established, monumented, re-monumented, recovered, found as expressed below:

**NOTE: Not more than 4 corners, all in the same town and range, may be recorded on this certificate.**

	A	B	C	D	E	F	G	H	I	J	K	L	M
2	6	5	4	3	2	1							
3													
4	7	8	9	10	11	12							
5													
6	18	17	16	15	14	13							
7													
8	19	20	21	22	23	24							
9													
10	30	29	28	27	26	25							
11													
12	31	32	33	34	35	36							
13													


- A. Description of original monument and accessories and/or subsequent restoration:
- |                                            |                                           |                                           |
|--------------------------------------------|-------------------------------------------|-------------------------------------------|
| Post set by William A. Burt 1849           | 1977 recorded plat of Wooden Key Manor    | 1978, Cavanagh Survey                     |
| W. Oak 7" S15°W 23 links                   | Liber 7, Page 23                          | 1/2" bar                                  |
| Y. Pine 7" N50°W 14 links                  |                                           | Same witness as Liber 1, Page 109         |
|                                            |                                           | LCRC                                      |
| 1942 Henning Found 1/2" bar in road        | 1978 LCRC, L. Cavanagh, Liber 1, Page 109 |                                           |
| US Bt stump on N side of road              | 1/2" steel bar                            |                                           |
|                                            | 24" B. Oak N60W 61.42                     | 1979 LCRC, L. Cavanagh, Liber 1, Page 131 |
| 1968 recorded plat of Woodland Hills No. 2 | 8" B. Oak North 43.40                     | 1/2" bar                                  |
| Liber 6, Page 13                           | 12" B. Oak S70W 56.88                     | 12" B. Oak N27W 26.7                      |
|                                            | Conc. Mon. south 33.0                     | 6" B. Oak S45E 46.07                      |
|                                            |                                           | 12" W. Oak S20W 24.7                      |

- B. Description of corner evidence found and/or method applied in restoring or reestablishing corner:  
Found 1/2" bar in road  
Concrete Monument South 33.0 feet

- C. Description of monument for corner and accessories established to perpetuate locating the position of the corner:

Set 2 1/2" x 24" cast iron Roscommon County Monument  
Stamped 17614-1994  
S3°W spike in 8" B. Oak 53.18 feet  
S44°W spike in 8" B. Oak 70.43 feet  
N4°E spike in 7" R. Oak 49.34 feet  
N60°W spike in 7" R. Oak 72.04 feet  
South concrete monument 33.0 feet

Is accepted as a perpetuation of the original government corner.

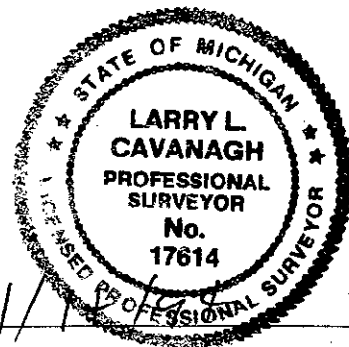

Signed by Larry L. Cavanagh  
Surveyor's Michigan License No. 17614

Date 11/11/94