

3894

LAND CORNER RECORDATION CERTIFICATE
Filing Requirement of Act 74, Mich P.A. 1970

For corners in
Roscommon County

Located in: Corner Code #

1. Public Land Survey

T22N	R 3W	D-13	✓
T21N	R3W	D-1	
T	R		
T	R		

STATE OF MICHIGAN
ROSCOMMON COUNTY
RECORDED

19 MAY 98 11:09 A.M.

ROBERT W. SMITH
REGISTER OF DEEDS

FILE IN LIBER 3 OF LAND CORNER

Register of Deeds Stamp & File Number

I, Larry L. Cavanagh, in a field survey April, 1998, do hereby certify that under requirements of P.A. 74, Michigan P.A. of 1970, the corner points mentioned in line 1 above was in conformance with regulations and rules therefore as required in the current manual of survey instructions of the United States Department of the Interior, Bureau of Land Management or by a decree of a Court of Law; established, re-established, monumented, recovered, found as expressed below:

A. Description of original monument and accessories and/or subsequent restoration:

JOHN BRINK 1838
SET QUARTER SEC. POST
WHITE OAK 12 N25 1/2E 43
WHITE PINE 8 N25 1/2W 66

DNR 1930'S
FOUND U.S. BEARINGS

SCHAAF INDICATES IRON
SET

	A	B	C	D	E	F	G	H	I	J	K	L	M
2	6	5	4	3	2	1							
3													
4	7	8	9	10	11	12							
5													
6	18	17	16	15	14	13							
7													
8	19	20	21	22	23	24							
9													
10	30	29	28	27	26	25							
11													
12	31	32	33	34	35	36							
13													

B. Description of corner evidence found and/or method applied in restoring or reestablishing corner:

FOUND 1 1/4 X 2 PIPE
BLAZED N. PINE NW

C. Description of monument for corner and accessories established to perpetuate locating the position of the corner:

SET STANDARD ROSCOMMON COUNTY MONUMENT STAMPED 17614
WIT: NAIL & TAG IN 14' NORWAY N45°E 65.93'
NAIL & TAG IN 18' NORWAY N40°W 62.99'
NAIL & TAG IN 12' W. PINE S36°E 68.75'
NAIL & TAG IN 11' NORWAY S37°W 72.20'
CARSONITE POST NORTH 30.25'

A PERPETUATION OF THE ORIGINAL GOVERNMENT CORNER.

SURVEY &
REMONUMENTATION

OCT 05 1998


SECTION

ROSCOMMON COUNTY
PEER GROUP APPROVAL
DATE May 15th 1998

Marvin E. Myers
Marvin E. Myers, P.S.
County Surveyor

Signed by *Larry L. Cavanagh*
Surveyor's Michigan License NO. 17614

Date May 16, 1998

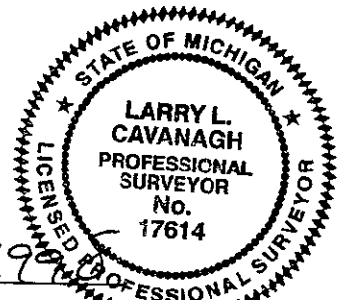

FORM APPROVED BY MICHIGAN STATE BOARD OF LAND SURVEYORS, JAN 28, 1971
REVISED MAY 14, 1975
REVISED JAN., 1983

LIBER 3 PAGE 505