

18953 1993A

ROSCOMMON COUNTY REMONUMENTATION

STATE OF MICHIGAN  
COUNTY OF ROSCOMMON  
REC-1000

COMMISSION

LAND CORNER RECORDATION CERTIFICATE

Dec 16 9 21 AM '93

Filing Requirement of Act 74, Mich. P.A. 1970

For corners in

Roscommon (County)	Located In:	Corner Code #
1. Public Land Survey	T 22N R 3W	E-7
	T R	
	T R	
	T R	
2. Property Controlling in Section	S T R	
	S T R	
3. Miscellaneous Property in Sec.	S T R	
	S T R	
4. Lot No. _____, Recorded Plat _____		
5. Private Claims _____		

*Robert...*  
REGISTERED

ROSCOMMON COUNTY  
PEER GROUP APPROVAL

DATE 11-30-93

TO BE FILED IN LIBER 3 OF LAND CORNERS  
Register of Deeds Stamp & File Number

I, Larry L. Cavanagh, in a field survey on November, 1993, do hereby certify that under requirements of P.A. 74, Michigan P.A. of 1970, the corner points mentioned in lines 1 and 2 above were in conformance with regulations and rules therefore as required in the current manual of survey instructions of the United States Department of the Interior, Bureau of Land Management or by a decree of a Court of Law and/or that the corner points mentioned in lines 3, 4 and 5 above were in conformance with the rules of the Michigan Board of Land Surveyors or by a Decree of a Court of Law; established, re-established, monumented, re-monumented, recovered, found as expressed below:

	A	B	C	D	E	F	G	H	I	J	K	L	M
2	6		5		4		3		2		1		
3													
4	7		8		9		10		11		12		
5													
6	13		17		16		15		14		13		
7													
8	19		20		21		22		23		24		
9													
10	30		29		28		27		26		25		
11													
12	31		32		33		34		35		36		
13													

NOTE: Not more than 4 corners, all in the same town and range, may be recorded on this certificate.

A. Description of original monument and accessories and/or subsequent restoration:

W/Post placed by Wm. A. Burt 1849 1972 L. Cavanagh, RLS Sec survey S 1/2 Sec 16  
 Y Pine 16" N38°E 49 Lks Iron in Pav't Box  
 Y Pine 16" N20°W 11 Lks 16" W. Oak N30°W 57.8  
 Fence corner S55°W 41.5

1940 J. Richardson, RLS field book  
 Found pipe  
 NBT - Y Pine 14" S72 3/4°W 107.1  
 R Oak 8" S41 1/2°E 57.4

1973 Land corner recordation  
 Found 1/2" solid iron in Mon Box &  
 accepted as corner  
 Steel Fe post S45°W 41.55  
 12" Oak N35°W 58.22  
 22" Oak N65°E 95.36

1957± Liber 2 corner record  
 Fence corner S44°W 41.05  
 B Oak N87°E 38.81  
 W Oak S50°E 57.76

B. Description of corner evidence found and/or method applied in restoring or reestablishing corner.


Found 1/2" Bar in Pav't Box (over 1 1/2" pipe)  
 NW W. Oak 1972-1973  
 SE W. Oak 1975  
 SW F. Corner 1972

And accepted as a careful and faithful perpetuation of the position of the original corner.

See filed dossier for detail of report.

C. Description of monument for corner and accessories established to perpetuate locating the position of the corner:

Set Roscommon Co. Std Mon stamped C-7 17614  
 N35°W Nail & tag in 18" W. Oak 58.1  
 S34°W Nail & tag in 12" R. Pine 49.22  
 S50°E nail & tag in 8" W. Oak 58.02  
 N38°E nail & tag in W. Pine 57.30

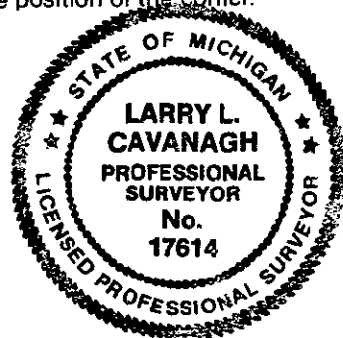

Signed by Larry L. Cavanagh  
 Surveyor's Michigan License No. 17614

Date 12-15-93

Date Nov 30, 1993

Peer Group Approved

FORM APPROVED BY MICHIGAN STATE BOARD OF LAND SURVEYORS, JAN. 28, 1971  
REVISED MAY 14, 1975  
REVISED JAN., 1983