

ROSCOMMON COUNTY REMONUMENTATION

8956 B 1 S 1094

LAND CORNER RECORDATION CERTIFICATE
Filing Requirement of Act 74, Mich. P.A. 1970

Dec 16 9 21 AM '93

For corners in
Roscommon
(County)

Located In: _____ Corner Code # _____

- | | | | |
|------------------------------------|---------------|--------------|------------|
| 1. Public Land Survey | T <u>22</u> N | R <u>3</u> W | <u>G-5</u> |
| | T _____ | R _____ | _____ |
| | T _____ | R _____ | _____ |
| | T _____ | R _____ | _____ |
| 2. Property Controlling in Section | S _____ | T _____ | R _____ |
| | S _____ | T _____ | R _____ |
| 3. Miscellaneous Property in Sec. | S _____ | T _____ | R _____ |
| | S _____ | T _____ | R _____ |
4. Lot No. _____, Recorded Plat _____
5. Private Claims _____

ROSCOMMON COUNTY
PEER GROUP APPROVAL
DATE 12-14-93
TO BE FILED IN LIBER 3 OF LAND CORNERS
Register of Deeds Stamp & File Number

I, Larry L. Cavanagh, in a field survey on November, 19 93, do hereby certify that under requirements of P.A. 74, Michigan P.A. of 1970, the corner points mentioned in lines 1 and 2 above were in conformance with regulations and rules therefore as required in the current manual of survey instructions of the United States Department of the Interior, Bureau of Land Management or by a decree of a Court of Law and/or that the corner points mentioned in lines 3, 4 and 5 above were in conformance with the rules of the Michigan Board of Land Surveyors or by a Decree of a Court of Law; established, re-established, monumented, re-monumented, recovered, found as expressed below:

	A	B	C	D	E	F	G	H	I	J	K	L	M
2	6	5	4	3	2	1							
3													
4	7	8	9	10	11	12							
5													
6	18	17	16	15	14	13							
7													
8	19	20	21	22	23	24							
9													
10	30	29	28	27	26	25							
11													
12	31	32	33	34	35	36							
13													

NOTE: Not more than 4 corners, all in the same town and range, may be recorded on this certificate.


- A. Description of original monument and accessories and/or subsequent restoration:
- | | |
|------------------------------------|--|
| W/post placed by Wm A. Burt 1849 | 1963 Cherokee Village No. 3 L-5, P-15 |
| Cedar 7" N89°E 6 | 1968 Houghton Lake Forest No. 2 L-6, P-14 |
| Cedar 7" S52°W 11 | 1977 L. Cavanagh Sec sub survey of N½ Sec 16 |
| 1940 J. Richardson RLS field bood | Found 3/4" pipe (Believed miss-recorded) |
| Old Bs & post | 12" Ash N55°E 34.1 |
| NBT Ash 16" N70°E 13.5 | 7" Cedar S30°E 49.55 |
| Cedar 12" N46 3/4°W 13.93 | 7" Cedar S85°W 27.4 |
| 1946 Robert I. Ostling sec. survey | |
| 1 1/2" pipe & cedar post | |
| NBT Ash 14" N21 1/2°E 13.8 | |
| BNT Cedar 18" N47 1/2°W 13.8 | |

- B. Description of corner evidence found and/or method applied in restoring or reestablishing corner:
- Found 1 1/2" x 36" pipe
Found 12" Ash (Now dead) NE
Found 7" Cedar (Now dead) recorded S85°W 27.4, Meas. N85°W 27.4

NOTE: Ostling notes Richardson's witnesses in 1946 and ties the plat of Cherokee Village No. 3 to corner in 1963. The same tie was noted in Cavanagh survey (N½ of Section 16 in 1977) therefore this is accepted as a careful and faithful perpetuation of the position of the original corner.

See filed dossier for detail of report.

- C. Description of monument for corner and accessories established to perpetuate locating the position of the
- Left 1 1/2" x 36" pipe, drove 3/4" pipe in 1 1/2" pipe with cap.
N55°E Nail & tag in 12" Ash (dead) 34.52
N85°W Nail & tag in 7" Cedar (dead) 27.46
N52°E Nail & tag in 5" Cedar (dead) 50.70
S05°W Nail & tag in 7" Cedar (dead) 8.69

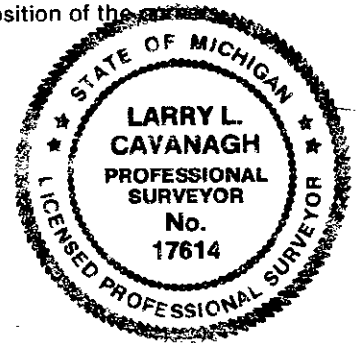

Signed by Larry L. Cavanagh Date 12-15-93
Surveyor's Michigan License No. 17614

Date December 14, 1993 Peer Group Approved
LIBER 3 PAGE 22