

ROSCOMMON COUNTY REMONUMENTATION

DEC 16 9 21 AM '93

8957

FEB 18 1994
COMMISSION

LAND CORNER RECORDATION CERTIFICATE
Filing Requirement of Act 74, Mich. P.A. 1970

For corners in

| Roscommon (County) | Located In: | Corner Code # |
|---------------------------------------|-------------------------|---------------|
| 1. Public Land Survey | T 22N R 3W | 6-6 |
| | T _____ R _____ | _____ |
| | T _____ R _____ | _____ |
| | T _____ R _____ | _____ |
| 2. Property Controlling in Section | S _____ T _____ R _____ | _____ |
| | S _____ T _____ R _____ | _____ |
| 3. Miscellaneous Property in Sec. | S _____ T _____ R _____ | _____ |
| | S _____ T _____ R _____ | _____ |

Richard L. Cavanagh
REGISTER

ROSCOMMON COUNTY
PEER GROUP APPROVAL

DATE 11-30-93

TO BE FILED IN LIBER 3 OF LAND CORNER

Register of Deeds Stamp & File Number

4. Lot No. _____, Recorded Plat _____
5. Private Claims _____

| | A | B | C | D | E | F | G | H | I | J | K | L | M |
|----|----|----|----|----|----|----|---|---|---|---|---|---|---|
| 2 | 6 | 5 | 4 | 3 | 2 | 1 | | | | | | | |
| 3 | | | | | | | | | | | | | |
| 4 | 7 | 8 | 9 | 10 | 11 | 12 | | | | | | | |
| 5 | | | | | | | | | | | | | |
| 6 | 18 | 17 | 16 | 15 | 14 | 13 | | | | | | | |
| 7 | | | | | | | | | | | | | |
| 8 | 19 | 20 | 21 | 22 | 23 | 24 | | | | | | | |
| 9 | | | | | | | | | | | | | |
| 10 | 30 | 29 | 28 | 27 | 26 | 25 | | | | | | | |
| 11 | | | | | | | | | | | | | |
| 12 | 31 | 32 | 33 | 34 | 35 | 36 | | | | | | | |
| 13 | | | | | | | | | | | | | |

I, Larry L. Cavanagh, in a field survey on November, 1993, do hereby certify that under requirements of P.A. 74, Michigan P.A. of 1970, the corner points mentioned in lines 1 and 2 above were in conformance with regulations and rules therefore as required in the current manual of survey instructions of the United States Department of the Interior, Bureau of Land Management or by a decree of a Court of Law and/or that the corner points mentioned in lines 3, 4 and 5 above were in conformance with the rules of the Michigan Board of Land Surveyors or by a Decree of a Court of Law; established, re-established, monumented, re-monumented, recovered, found as expressed below:

NOTE: Not more than 4 corners, all in the same town and range, may be recorded on this certificate.

A. Description of original monument and accessories and/or subsequent restoration:

W/post placed by Wm A. Burt 1849
Hemlock 14" N11°W 9
Pine 12" S38°W 9

1946 Robert I. Ostling Sec survey
1/2"x12" bar
Spike in Aspen 8" N54 1/2°E 65.5
Spike in Aspen 5" N27 1/2°W 49.9

1968 White Deer No. 2 L-6, P-18

1972 L. Cavanagh S 1/2 Sec 16
fd boat spike in Pav't box
Power pole NW 52.6
Power pole SW 57.2

1979 Deerwood Village L-7, P-31
1957 MDO1 Plans, apparent same location
Also previous older plans (No date)


B. Description of corner evidence found and/or method applied in restoring or reestablishing corner:

Found 1/2" Boat spike in Mon Box over old wooden stake 1.0 N of centerline of M-55, and in accepted as the best available evidence of the position of the original corner.

See filed dossier for detail of report.

C. Description of monument for corner and accessories established to perpetuate locating the position of the corner:

Set Roscommon Co. Std. Mon in West edge of Pav't box stamped G-6 17614
N5 1/2°E Nail & tag in I. Pole 31.45
S43°E Nail & tag in P. Pole 39.23
S15°E Nail & tag in P. pole 106.57
S36°W Nail & tag in Denton Twp Cemetery sign post 48.64

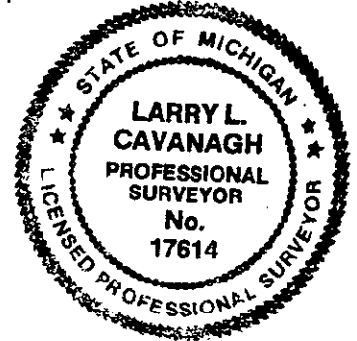

Signed by *Larry L. Cavanagh* Date 12-15-93
Surveyor's Michigan License No. 17614

Date November 30 1993 Peer Group Approved