

3897

LAND CORNER RECORDATION CERTIFICATE  
Filing Requirement of Act 74, Mich P.A. 1970

For corners in  
Roscommon County

Located in: Corner Code #

1. Public Land Survey

T22N R3W G-13  
T21N R3W G-1  
T R  
T R

STATE OF MICHIGAN  
ROSCOMMON COUNTY  
RECORDED

19 MAY 98 11:09 A.M.

ROBERT W. SMITH  
REGISTER OF DEEDS

I, Larry L. Cavanagh, in a field survey April, 1998, do hereby certify that under requirements of P.A. 74, Michigan P.A. of 1970, the corner points mentioned in line 1 above was in conformance with regulations and rules therefore as required in the current manual of survey instructions of the United States Department of the Interior, Bureau of Land Management or by a decree of a Court of Law, established, re-established, monumented, recovered, found as expressed below:

FILE IN LIBER 3 OF LAND CORNER  
Register of Deeds Stamp & File Number

A. Description of original monument and accessories and/or subsequent restoration:

JOHN BRINK 1838  
SET POST CORNER  
YELLOW PINE 10 N56E 38  
YELLOW PINE 12 N26W 59

LCRC L2, P249 1970'S  
CONC. MON.  
24' R. PINE N70°E 98.40'  
8' R. PINE S61°E 63.95'  
12' OAK S68°E 84.17'

WILLIAM A BURT 1850  
W. PINE 16 S53°W 21  
W. PINE 12 S45°E 19

C. EUGENE OSTLING LCRC 1971  
L2, P21  
CONC. MON.  
24' R. PINE N70°29'E 98.4'  
8' R. PINE S61°09'E 63.95'  
12' OAK S68°20'E 84.17'

DNR 1930'S  
ESTABLISHED CORNER  
N.B.T.  
W. PINE STUMP 36 N6W 33

C. EUGENE OSTLING 12026 1971  
CONC. MON.  
SAME WITNESSES AS ABOVE

SCHAAF INDICATES IRON  
SET

C. EUGENE OSTLING 12026 1975  
L305 P688  
NO WITNESSES

	A	B	C	D	E	F	G	H	I	J	K	L	M
2	6	5	4	3	2	1							
3													
4	7	8	9	10	11	12							
5													
6	18	17	16	15	14	13							
7													
8	19	20	21	22	23	24							
9													
10	30	29	28	27	26	25							
11													
12	31	32	33	34	35	36							
13													

B. Description of corner evidence found and/or method applied in restoring or reestablishing corner:

FOUND 1/2" X 18" STEEL BAR OVER 4'X3' CONC PLAT MON

C. Description of monument for corner and accessories established to perpetuate locating the position of the corner:

SET STANDARD ROSCOMMON COUNTY MONUMENT STAMPED 17614  
WIT: NAIL & TAG IN 12' B. OAK N37°W 60.55'  
NAIL & TAG IN 18' NORWAY N07°E 71.51'  
NAIL & TAG IN 24' NORWAY N70°E 98.48'  
NAIL & TAG IN 13' W. PINE S48°E 33.78'  
NAIL & TAG IN 6' J. PINE S65°W 78.29'  
CARSONITE POST S30°W 28.0

SURVEY &  
REMONUMENTATION


THE BEST AVAILABLE EVIDENCE OF THE POSITION OF THE ORIGINAL CORNER.

OCT 05 1998

ROSCOMMON COUNTY  
PEER GROUP APPROVAL  
DATE MAY 16 1998

SECTION

*Marvin E. Myers*  
Marvin E. Myers, P.S.  
County Surveyor

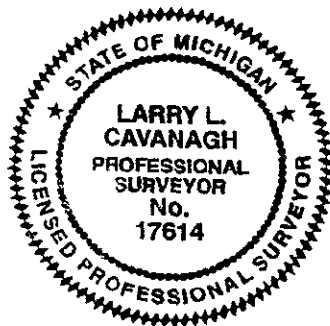

Signed by *Larry L. Cavanagh*  
Surveyor's Michigan License No. 17614

Date May 16, 1998

FORM APPROVED BY MICHIGAN STATE BOARD OF LAND SURVEYORS, JAN 28, 1971  
REVISED MAY 14, 1975  
REVISED JAN., 1983