

3899

LAND CORNER RECORDATION CERTIFICATE
Filing Requirement of Act 74, Mich P.A. 1970

For corners in
Roscommon County

Located in: Corner Code #

1. Public Land Survey

T22N	R3W	I-13
T21N	R3W	I-1
T	R	
T	R	

STATE OF MICHIGAN
ROSCOMMON COUNTY
RECORDED
19 MAY 98 11:10 A.M.
ROBERT W. SMITH
REGISTER OF DEEDS
FILE IN LIBER 3 OF LAND CORN
Register of Deeds Stamp & File Number

I, Larry L. Cavanagh, in a field survey April, 1998, do hereby certify that under requirements of P.A. 74, Michigan P.A. of 1970, the corner points mentioned in line 1 above was in conformance with regulations and rules therefore as required in the current manual of survey instructions of the United States Department of the Interior, Bureau of Land Management or by a decree of a Court of Law; established, re-established, monumented, recovered, found as expressed below:

A. Description of original monument and accessories and/or subsequent restoration:

JOHN BRINK 1838
SET POST
PITCH PINE 10 N7 1/2E 90
PITCH PINE 10 N57W 103

SCHAAF INDICATES STAKE
SET IN PREPARATION FOR
IRON

WILLIAM A BURT 1850
S PINE 10 S52E 30
S PINE 6 S39W 55

LCRC 1970'S, L2, P247
2' PIPE
7' E. OAK N15°W 34.25'
8' R. PINE S10°W 22.65'

DNR 1930'S
FOUND U.S. BEARINGS
N.B.T.
W. PINE STUMP 18 N30W 20 1/2

LARRY L. CAVANAGH 1974
SECTION SUB-DIVISION SURVEY
FD 2' PIPE
SAME WITNESSES AS ABOVE

	A	B	C	D	E	F	G	H	I	J	K	L	M
2	6	5	4	3	2	1							
3													
4	7	8	9	10	11	12							
5													
6	18	17	16	15	14	13							
7													
8	19	20	21	22	23	24							
9													
10	30	29	28	27	26	25							
11													
12	31	32	33	34	35	36							
13													

B. Description of corner evidence found and/or method applied in restoring or reestablishing corner:

FOUND 2' PIPE IN 8' X 8' CONCRETE BASE
FIRE TRAIL NORTH
FIRE TRAIL SOUTH 30° EAST
FOUND R. PINE S10°W 22.65'
FOUND J. PINE STUMP SE

C. Description of monument for corner and accessories established to perpetuate locating the position of the corner:

SET STANDARD ROSCOMMON COUNTY MONUMENT STAMPED 17614
WIT: NAIL & TAG IN 9' NORWAY S13°E 45.76'
NAIL & TAG IN 13' NORWAY S15°W 22.72'
NAIL & TAG IN 4' J. PINE N13°W 52.94'
NAIL & TAG IN STUMP S32°E 23.85'
CARSONITE POST N40E 38.12'

A PERPETUATION OF THE ORIGINAL GOVERNMENT CORNER.

SURVEY &
REMONUMENTATION


OCT 05 1998

SECTION

ROSCOMMON COUNTY
PEER GROUP APPROVAL

DATE March 15 24 1998

Marvin E. Myers
Marvin E. Myers, P.S.
County Surveyor

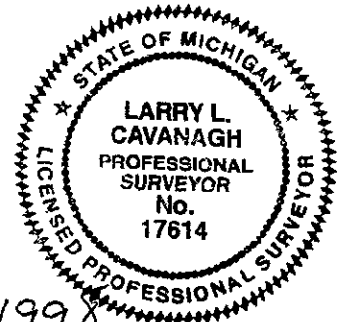

Signed by *Larry L. Cavanagh* Date May 16, 1998
Surveyor's Michigan License No. 17614

FORM APPROVED BY MICHIGAN STATE BOARD OF LAND SURVEYORS, JAN 28, 1971
REVISED MAY 14, 1975
REVISED JAN., 1983

LIBER 3 PAGE 510