

**SURVEY &
REMONUMENTATION**

8832

MAY 28 1997

LAND CORNER RECORDATION CERTIFICATE
Filing Requirement of Act 74, Mich. P.A. 1970

STATE OF MICHIGAN
ROSCOMMON COUNTY
RECORDED

For corners in
ROSCOMMON
(County)

Located In:

Corner Code #

22 NOV 96 1:01 P.M.

- | | | | | | |
|--------------------------------------|---|------------|---|-----------|------------|
| 1. Public Land Survey | T | <u>22N</u> | R | <u>3W</u> | <u>L-3</u> |
| | T | _____ | R | _____ | _____ |
| | T | _____ | R | _____ | _____ |
| | T | _____ | R | _____ | _____ |
| 2. Property Controlling in Section | S | _____ | T | _____ | _____ |
| | S | _____ | T | _____ | _____ |
| 3. Miscellaneous Property in Section | S | _____ | T | _____ | _____ |
| | S | _____ | T | _____ | _____ |

ROBERT W. SMITH
REGISTER OF DEEDS

**TO BE FILED IN LIBER 3 OF LAND CORNER
Register of Deeds Stamp & File Number**

4. Lot No. _____, Recorded Plat _____
5. Private Claims _____

A	B	C	D	E	F	G	H	I	J	K	L	M
2	6	5	4	3	2	1						
3												
4	7	8	9	10	11	12						
5												
6	18	17	16	15	14	13						
7												
8	19	20	21	22	23	24						
9												
10	30	29	28	27	26	25						
11												
12	31	32	33	34	35	36						
13												

I, Larry L. Cavanagh, in a field survey on October, 19 96, do hereby certify that under requirements of P.A. 74, Michigan P.A. of 1970, the corner points mentioned in lines 1 and 2 above were in conformance with regulations and rules therefore as required in the current manual of survey instructions of the United States Department of the Interior, Bureau of Land Management or by a decree of a Court of Law and/or that the corner points mentioned in lines 3, 4 and 5 above were in conformance with the rules of the Michigan Board of Professional Surveyors or by a Decree of a Court of Law; established, re-established, monumented, re-monumented, recovered, found as expressed below:

NOTE: Not more than 4 corners, all in the same town and range, may be recorded on this certificate.

A. Description of original monument and accessories and/or subsequent restoration:

POST SET WILLIAM A BURT 1849
TAMARACK 5" N45°E 2 LKS
TAMARACK 5" S45°W 4 LKS

B. Description of corner evidence found and/or method applied in restoring or reestablishing corner:


NONE
CORNER RE-ESTABLISHED AT POINT MID-WAY AND ON LINE BETWEEN THE SECTION CORNERS
2658.69 FEET PER 1/2 MILES MEASURED
2660.46 FEET PER 1/2 MILE GLO

ROSCOMMON COUNTY
PEER GROUP APPROVAL
DATE NOV 1, 1996
Marvin E. Myers, P.S.
County Surveyor

C. Description of monument for corner and accessories established to perpetuate locating the position of the corner:

SET STANDARD ROSCOMMON COUNTY MONUMENT (3' X 21" BRASS CAP #17614)
10" CEDAR S45°W 22.37'
11" MAPLE N60°W 11.00'
12" CEDAR N25°E 20.25'
12" CEDAR EAST 9.80'
CARSONITE POST NORTH 0.9'

ACCEPTED AS THE THE BEST AVAILABLE EVIDENCE OF THE RE-ESTABLISHMENT OF THE ORIGINAL CORNER.

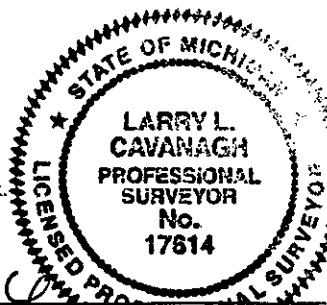

Signed by Larry L. Cavanagh
Surveyor's Michigan License No. 17614

Date Nov 9, 1996