

3902

LAND CORNER RECORDATION CERTIFICATE  
Filing Requirement of Act 74, Mich P.A. 1970

For corners in  
Roscommon County

Located in: Corner Code #

1. Public Land Survey

T22N	R3W	L-13
T21N	R3W	L-1
T	R	
T	R	

STATE OF MICHIGAN  
ROSCOMMON COUNTY  
RECORDED

19 MAY 98 11:10 A.M.

ROBERT W. SMITH  
REGISTER OF DEEDS

I, Larry L. Cavanagh, in a field survey April, 1998, do hereby certify that under requirements of P.A. 74, Michigan P.A. of 1970, the corner points mentioned in line 1 above was in conformance with regulations and rules therefore as required in the current manual of survey instructions of the United States Department of the Interior, Bureau of Land Management or by a decree of a Court of Law; established, re-established, monumented, recovered, found as expressed below:

FILE IN LIBER 3 OF LAND CORNERS  
Register of Deeds Stamp & File Number

	A	B	C	D	E	F	G	H	I	J	K	L	M
2	6	5	4	3	2	1							
3													
4	7	8	9	10	11	12							
5													
6	18	17	16	15	14	13							
7													
8	18	20	21	22	23	24							
9													
10	30	29	28	27	26	25							
11													
12	31	32	33	34	35	36							
13													

A. Description of original monument and accessories and/or subsequent restoration

JOHN BRINK 1838	LCRC, 1970'S, L2 P251
SET POST	2" PIPE
PITCH PINE 8 N29E 18	5" R. PINE S64E 50.4'
PITCH PINE 8 N21W 16	6" R. PINE S40W 19.6'
DNR 1930'S	KENNETH J. OSTLING, LCRC 1974
FOUND U.S. BEARINGS	L1 P 105
NO TREES FOR N.B.T.	LEFT 2" PIPE
	5" R. PINE S64°E 50.4'
SCHAAF INDICATES STAKE	6" R. PINE S40°W 19.6'
SET IN PREPARATION FOR IRON	

B. Description of corner evidence found and/or method applied in restoring or reestablishing corner:

FOUND 2" PIPE WITH 8" X 8" X 3" CONCRETE BASE  
BOTH 1974 WITNESSES

C. Description of monument for corner and accessories established to perpetuate locating the position of the corner:

SET STANDARD ROSCOMMON COUNTY MONUMENT STAMPED 17614  
WT: NAIL & TAG IN 8" B. OAK N60°W 27.01'  
NAIL & TAG IN 11" NORWAY S32°W 19.77'  
NAIL & TAG IN 11" NORWAY S70°E 50.58'  
CARSONITE POST NORTH 13.36'

A PERPETUATION OF THE ORIGINAL GOVERNMENT CORNER.


SURVEY &  
REMONUMENTATION

OCT 05 1998

SECTION

ROSCOMMON COUNTY  
PEER GROUP APPROVAL  
DATE April 15<sup>th</sup> 1998

*Marvin E. Myers*  
Marvin E. Myers, P.S.  
County Surveyor

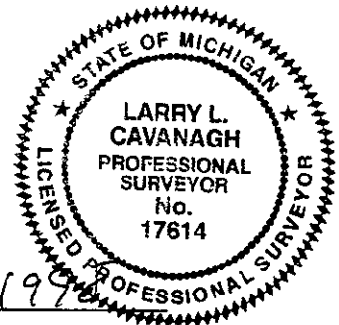

Signed by *Larry L. Cavanagh*  
Surveyor's Michigan License No. 17614

Date MAY 16, 1998

FORM APPROVED BY MICHIGAN STATE BOARD OF LAND SURVEYORS, JAN 28, 1971  
REVISED MAY 14, 1975  
REVISED JAN., 1983