SURVEY &
REMONUMENTATION
8346
APR 2 4 1995
COMMISSION

ROSCOMMON COUNTY REMONUMENTATION TO BE FILED IN LIBER 3 OF LAND CORNERS

LAND CORNER RECORDATION CERTIFICATE

Filing Requirement of Act 74, Mich. P.A. 1970

STATE OF MICHIGAN
ROSCOMMON COUNTY
RECORDED

14 NOV 94 3:06 P.M.

ROBERT W. SMITH
REGISTER OF DEEDS

ROSCOMMON COUNTY
PEER GROUP APPROVAL
DATE 10-20-94

Register of Deeds Stamp & File Number

For corners in Roscommon (County)

	Located In:	Corner Code #
1. Public Land Survey	T 22N R 3W	M-8
	T ___ R ___	
	T ___ R ___	
	T ___ R ___	
2. Property Controlling	S ___ T ___ R ___	
in Section	S ___ T ___ R ___	
3. Miscellaneous	S ___ T ___ R ___	
Property in Sec.	S ___ T ___ R ___	

4. Lot No. _____, Recorded Plat _____
5. Private Claims _____

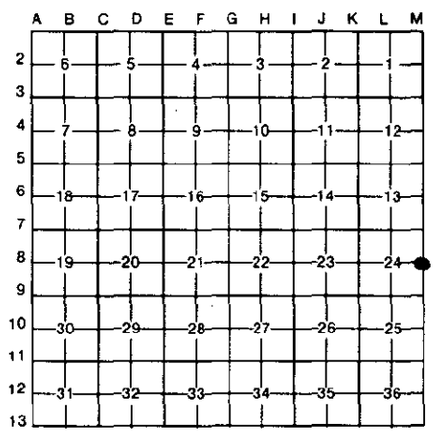

I, Larry L. Cavanagh, in a field survey on September, 19 94, do hereby certify that under requirements of P.A. 74, Michigan P.A. of 1970, the corner points mentioned in lines 1 and 2 above were in conformance with regulations and rules therefore as required in the current manual of survey instructions of the United States Department of the Interior, Bureau of Land Management or by a decree of a Court of Law and/or that the corner points mentioned in lines 3, 4 and 5 above were in conformance with the rules of the Michigan Board of Land Surveyors or by a Decree of a Court of Law; established, re-established, monumented, re-monumented, recovered, found as expressed below:

NOTE: Not more than 4 corners, all in the same town and range, may be recorded on this certificate.

A. Description of original monument and accessories and/or subsequent restoration:

Post set by John Burt 1838
Tamarack 8" S65°W 5 links
Cedar 6" N20°W 7 links

Unrecorded DNR Plat indicates
reset by Schaaf

1973 LCRC, L. Cavanagh (list first 3 wit as below)

1980 Survey, L. Cavanagh, Liber 377, Pages 235-263
7" Cedar S65°W 12.4'
5" Cedar S90°E 7.8'
5" Cedar N80°E 14.9'
5" Cedar N30°W 3.95'

1980 Cavanagh, LCRC
Liber 1, Page 196
Same Wit.

B. Description of corner evidence found and/or method applied in restoring or reestablishing corner:

Found 2" pipe in concrete (Schaaf)
Found 3 of the 1980 Witnesses

C. Description of monument for corner and accessories established to perpetuate locating the position of the corner:

Set 2 /12" x 24" cast iron Roscommon County Monument
S50°E nail and tag in face of Blaze 5" Cedar 7.8'
N80°E nail and tag in face of Blaze 5" Cedar 15.02'
N30°W nail and tag in face of Blaze 5" Cedar 3.95'
S60°W nail and tag in 7" Tamarack 6.7'

Is accepted as the best available evidence of the position of the original corner.

STATE OF MICHIGAN
LARRY L. CAVANAGH
PROFESSIONAL SURVEYOR
No. 17614
LICENSED PROFESSIONAL SURVEYOR

Signed by Larry L. Cavanagh Date 11/14/9

Surveyor's Michigan License No. 17614

FORM APPROVED BY MICHIGAN STATE BOARD OF LAND SURVEYORS, JAN. 28, 1971
REVISED MAY 14, 1975
REVISED JAN., 1983

LIBER 3 PAGE 127