SURVEY &
REMONUMENTATION

8348

APR 2 4 1995

COMMISSION

ROSCOMMON COUNTY REMONUMENTATION TO BE FILED IN LIBER 3 OF LAND CORNERS

STATE OF MICHIGAN
ROSCOMMON COUNTY
RECORDED

14 NOV 94 3:06 P.M.

ROBERT W. SMITH
REGISTER OF DEEDS

ROSCOMMON COUNTY
PEER GROUP APPROVAL MEN
DATE 10 - 20 - 94
Register of Deeds Stamp & File Number

LAND CORNER RECORDATION CERTIFICATE

Filing Requirement of Act 74, Mich. P.A. 1970

For corners in Roscommon (County)

	Located In:	Corner Code #
1. Public Land Survey	T22N, R3W	M-10
	T ___ R ___	
	T ___ R ___	
	T ___ R ___	
2. Property Controlling	S ___ T ___ R ___	
in Section	S ___ T ___ R ___	
3. Miscellaneous	S ___ T ___ R ___	
Property in Sec.	S ___ T ___ R ___	

4. Lot No. _____, Recorded Plat _____
5. Private Claims _____

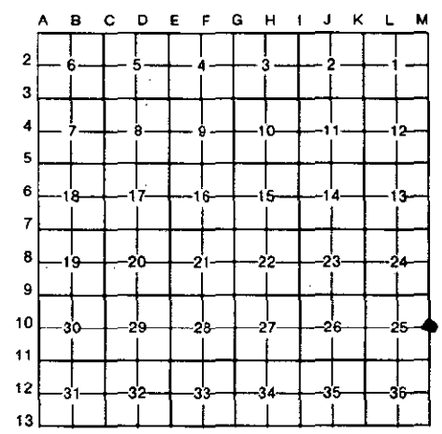

I, Larry L. Cavanagh, in a field survey on September, 19 94, do hereby certify that under requirements of P.A. 74, Michigan P.A. of 1970, the corner points mentioned in lines 1 and 2 above were in conformance with regulations and rules therefore as required in the current manual of survey instructions of the United States Department of the Interior, Bureau of Land Management or by a decree of a Court of Law and/or that the corner points mentioned in lines 3, 4 and 5 above were in conformance with the rules of the Michigan Board of Land Surveyors or by a Decree of a Court of Law; established, re-established, monumented, re-monumented, recovered, found as expressed below:

NOTE: Not more than 4 corners, all in the same town and range, may be recorded on this certificate.

A. Description of original monument and accessories and/or subsequent restoration:

Post set by John Burt 1838	1992 LCRC L. Cavanagh
Birch 6" S37°W 7 links	Liber 1, Page 311
Tamarak 8" N48°W 8 links	Found axle shaft
	New Witt
1982 Section Subdivision by Norman	3" Cedar N60°E 18.18'
Parker R.L.S.	6" Cedar S57°E 50.17
Calls for axle shaft in pipe	5" Cedar S85°W 36.66'
	5" Cedar N30°W 16.65

B. Description of corner evidence found and/or method applied in restoring or reestablishing corner:
Found axle shaft in pipe
All 1992 Wittnesses

C. Description of monument for corner and accessories established to perpetuate locating the position of the corner:

Set 2 1/2" x 24" cast iron Roscommon County Monument inside of 3" P.V.C. Pipe
17614 - 1994
nail and tag in 6" Cedar S57°E 50.10'
nail and tag in 3" Cedar N60°E 18.06'
nail and tag in 5" Cedar N30°E 16.60'
nail and tag in 5" Cedar S85°W 36.55'

Is accepted as the best available evidence of the position of the original corner

STATE OF MICHIGAN
LARRY L. CAVANAGH
PROFESSIONAL SURVEYOR
No. 17614
LICENSED PROFESSIONAL SURVEYOR

Signed by Larry L Cavanagh Date 11/14/94

Surveyor's Michigan License No. 17614

FORM APPROVED BY MICHIGAN STATE BOARD OF LAND SURVEYORS, JAN. 28, 1971
REVISED MAY 14, 1975
REVISED JAN., 1983

LIBER 3 PAGE 129