

2834

STATE OF MICHIGAN
COUNTY OF ROSCOMMON

ROSCOMMON COUNTY REMONUMENTATION

MAY 3 11 21 AM '94

LAND CORNER RECORDATION CERTIFICATE
Filing Requirement of Act 74, Mich. P.A. 1970

For corners in

Roscommon (County)	Located In:	Corner Code #
1. Public Land Survey	T 22N R 3W	G-6
	T _____ R _____	_____
	T _____ R _____	_____
	T _____ R _____	_____
2. Property Controlling in Section	S _____ T _____ R _____	_____
	S _____ T _____ R _____	_____
3. Miscellaneous Property in Sec.	S _____ T _____ R _____	_____
	S _____ T _____ R _____	_____

REGISTERED

MAM

**ROSCOMMON COUNTY
PEER GROUP APPROVAL**

DATE Nov. 30, 1993

TO BE FILED IN LIBER 3 OF LAND CORNER
Register of Deeds Stamp & File Number

- 4. Lot No. _____, Recorded Plat _____
- 5. Private Claims _____

A	B	C	D	E	F	G	H	I	J	K	L	M
2	6	5	4	3	2	1						
3												
4	7	8	9	10	11	12						
5												
6	18	17	16	15	14	13						
7												
8	19	20	21	22	23	24						
9												
10	30	29	28	27	26	25						
11												
12	31	32	33	34	35	36						
13												

I, Larry L. Cavanagh, in a field survey on November, 1993, do hereby certify that under requirements of P.A. 74, Michigan P.A. of 1970, the corner points mentioned in lines 1 and 2 above were in conformance with regulations and rules therefore as required in the current manual of survey instructions of the United States Department of the Interior, Bureau of Land Management or by a decree of a Court of Law and/or that the corner points mentioned in lines 3, 4 and 5 above were in conformance with the rules of the Michigan Board of Land Surveyors or by a Decree of a Court of Law; established, re-established, monumented, re-monumented, recovered, found as expressed below:

NOTE: Not more than 4 corners, all in the same town and range, may be recorded on this certificate.

A. Description of original monument and accessories and/or subsequent restoration:

- W/post placed by Wm A. Burt 1849
- Hemlock 14" N11°W 9
- Pine 12" S38°W 9
- 1946 Robert I. Ostling Sec survey
- 1/2"x12" bar
- Spike in Aspen 8" N54 1/2°E 65.5
- Spike in Aspen 5" N27 1/2°W 49.9
- 1968 White Deer No. 2 L-6, P-18
- 1992 L. Cavanagh S 1/2 Sec 16
- Fd boat spike in Pav't box
- Power pole NW 52.6
- Power pole SW 57.2
- 1979 Deerwood Village L-7, P-31
- 1957 MDOI Plans, apparent same location
- Also previous older plans (No date)

B. Description of corner evidence found and/or method applied in restoring or reestablishing corner:

Found 1/2" Boat spike in Mon Box over old wooden stake 1.0 N of centerline of M-55, and is accepted as the best available evidence of the position of the original corner.

See filed dossier for detail of report.


**SURVEY &
REMONUMENTATION**

MAY 24 1995

COMMISSION

C. Description of monument for corner and accessories established to perpetuate locating the position of the corner:

- Set Roscommon Co. Std. Mon in Pav't Box E. edge Pav't Box stamped E-6 17614
- S59°W Nail & tag in P. pole 58.08
- N2°E Nail & tag in P. pole 40.64
- S64°E Nail & tag in Htn Lk Hist. Vill. Sign post 102.45
- N22°E Nail & tag in 6" Maple 78.90

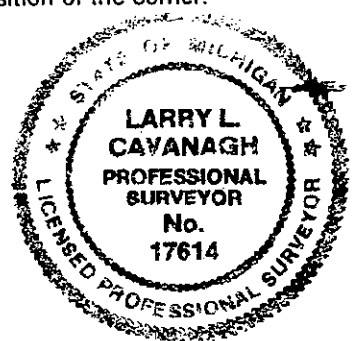

* THIS CERTIFICATE IS FILED TO CORRECT CERTIFICATE PREVIOUSLY FILED IN LIBER 3 PAGE 23 OF CORNERS. THE WITNESSES WERE PREVIOUSLY INTERCHANGED WITH E-6.

Signed by Larry L. Cavanagh Date 4/26/94

Surveyor's Michigan License No. 17614

FORM APPROVED BY MICHIGAN STATE BOARD OF LAND SURVEYORS, JAN. 28, 1971
REVISED MAY 14, 1971
REVISED JAN., 1981

Date November 30, 1993 Peer Group Approved

LIBER 3 PAGE 93