

ROSCOMMON COUNTY REMONUMENTATION

9064 FEB 18 1994

LAND CORNER RECORDATION CERTIFICATE
Filing Requirement of Act 74, Mich. P.A. 1970

DEC 21 10 51 AM '93

For corners in

COMMISSION

ROSCOMMON (County)	Located In:	Corner Code #
1. Public Land Survey	T <u>22N</u> R <u>4W</u>	<u>E-2</u>
	T _____ R _____	_____
	T _____ R _____	_____
	T _____ R _____	_____
2. Property Controlling in Section	S _____ T _____ R _____	_____
	S _____ T _____ R _____	_____
3. Miscellaneous Property in Sec.	S _____ T _____ R _____	_____
	S _____ T _____ R _____	_____

Robert L. Lapham
REGISTERED SURVEYOR

ROSCOMMON COUNTY
PEER GROUP APPROVAL

DATE 11/30/93

TO BE FILED IN LIBER 3 OF LAND CORNERS

Register of Deeds Stamp & File Number

- 4. Lot No. _____, Recorded Plat _____
- 5. Private Claims _____

	A	B	C	D	E	F	G	H	I	J	K	L	M
2	6		5	4	3	2	1						
3													
4	7	8	9	10	11	12							
5													
6	18	17	16	15	14	13							
7													
8	19	20	21	22	23	24							
9													
10	30	29	28	27	26	25							
11													
12	31	32	33	34	35	36							
13													

TIMOTHY L. LAPHAM, in a field survey on November, 19 93, do hereby certify that under requirements of P.A. 74, Michigan P.A. of 1970, the corner points mentioned in lines 1 and 2 above were in conformance with regulations and rules therefore as required in the current manual of survey instructions of the United States Department of the Interior, Bureau of Land Management or by a decree of a Court of Law and/or that the corner points mentioned in lines 3, 4 and 5 above were in conformance with the rules of the Michigan Board of Land Surveyors or by a Decree of a Court of Law; established, re-established, monumented, re-monumented, recovered, found as expressed below:

NOTE: Not more than 4 corners, all in the same town and range, may be recorded on this certificate.

A. Description of original monument and accessories and/or subsequent restoration:


E-2: 1852, A.CURTIS, POST, ASPEN 12" N25W 15L, MAPLE 6" S65E 19L;
DATE UNKNOWN, SURVEYOR UNKNOWN, LCRC 2-255, NO INFO;
10/6/1972, HENNING, (132) 267-656, COR MATERIAL, 3 WITS;
DATE UNKNOWN, L.CAVANAGH, (132) 280-674, NO CORNER MAT, NO WITS;
8/4/1976, L.CAVANAGH, (132) 323-661, COR MAT, 2 WITS;

B. Description of corner evidence found and/or method applied in restoring or reestablishing corner:

E-2: FOUND 1/2" X 24" IRON WITH CAP GDH #2240, EXCAVATED TO 2' NO ADDITIONAL INFORMATION FOUND.
N75W 28.8' 8" ASPEN (STUMP)
N30E 99.5' 10" J.PINE
ACCEPTED FOUND CORNER AS BEST EVIDENCE OF POSITION OF ORIGINAL CORNER.
THIS CORNER ESTABLISHED IN ROSCOMMON COUNTY REMONUMENTATION PROGRAM.
SEE DOSSIER FOR DETAILED REPORT.

C. Description of monument for corner and accessories established to perpetuate locating the position of the corner:

E-2: SET 2" X 21" CAST IRON MONUMENT WITH BRASS ROSCOMMON COUNTY PLATE
AZ 38° 99.88' SPIKE AND TAG NW FACE 12" JACK PINE
AZ 154° 9.89' FOUND SPIKE NE FACE 5" POPLAR
AZ 309° 82.87' FOUND SPIKE SW FACE POWER POLE
AZ 214° 95.92' FOUND SPIKE NW FACE 14" POPLAR
AZ 180° 0.54' CARSONITE SURVEY MARKER POST

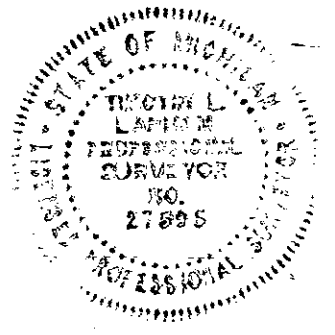

Signed by *Robert L. Lapham*

Date 12/20/93

Surveyor's Michigan License No. 27595

Date 11/30/93

Peer Group Approved

LIBER **3** PAGE **28**