

ROSCOMMON COUNTY REMONUMENTATION

LAND CORNER RECORDATION CERTIFICATE  
Filing Requirement of Act 74, Mich. P.A. 1970

DEC 21 10 51 AM '93

9081

FEB 18 1994

For corners in

ROSCOMMON (County)	Located In:	Corner Code #
1. Public Land Survey	T <u>22N</u> R <u>4W</u>	<u>F-1</u>
	T _____ R _____	_____
	T _____ R _____	_____
	T _____ R _____	_____
2. Property Controlling in Section	S _____ T _____ R _____	_____
	S _____ T _____ R _____	_____
3. Miscellaneous Property in Sec.	S _____ T _____ R _____	_____
	S _____ T _____ R _____	_____

ROSCOMMON COUNTY  
PEER GROUP APPROVAL  
DATE 11/30/93

TO BE FILED IN LIBER 3 OF LAND CORNERS  
Register of Deeds Stamp & File Number

4. Lot No. \_\_\_\_\_, Recorded Plat \_\_\_\_\_  
5. Private Claims \_\_\_\_\_

	A	B	C	D	E	F	G	H	I	J	K	L	M
2	6		5		4		3		2		1		
3													
4	7		8		9		10		11		12		
5													
6	18		17		16		15		14		13		
7													
8	19		20		21		22		23		24		
9													
10	30		29		28		27		26		25		
11													
12	31		32		33		34		35		36		
13													

I, TIMOTHY L. LAPHAM, in a field survey on November, 19 93, do hereby certify that under requirements of P.A. 74, Michigan P.A. of 1970, the corner points mentioned in lines 1 and 2 above were in conformance with regulations and rules therefore as required in the current manual of survey instructions of the United States Department of the Interior, Bureau of Land Management or by a decree of a Court of Law and/or that the corner points mentioned in lines 3, 4 and 5 above were in conformance with the rules of the Michigan Board of Land Surveyors or by a Decree of a Court of Law; established, re-established, monumented, re-monumented, recovered, found as expressed below:

NOTE: Not more than 4 corners, all in the same town and range, may be recorded on this certificate.

A. Description of original monument and accessories and/or subsequent restoration:


F-1: 1838, J.BRINK, POST, W PINE 12" N19E 30L, BIRCH 11" N40W, 36L; DATE AND SURVEYOR UNKNOWN LCRC 2-255, COR MAT, NO WIT; 3/23/1972, R.OSTLING, LCRC 1-35, COR MAT, NO WIT; 3/31/1972, R.OSTLING, (132) 259-487, COR MAT, 1 WIT; 12/1/1972, R.OSTLING, (132) 269-470, COR MAT, NO WIT; 2/21/1977, L.CAVANAGH, (132) 329-292, COR MAT, NO WIT; 7/25/1978, L.CAVANAGH, SRVY NOT REC, COR MAT, 4 WITS; 1/14/1979, L.CAVANAGH, LCRC 1-210, COR MAT, 3 WITS; 4/6/1984, L.CAVANAGH, SRVY NOT REC, NO NEW INFO; 8/16/1989, L.CAVANAGH, (132) 566-683, COR MAT, 4 WITS; 6/18/1990, L.CAVANAGH, (132) 589-447, COR MAT, 3 WITS; 7/8/1991, L.CAVANAGH, SRVY NOT REC, AMENDED 566-683, NO NEW INFO; 10/2/1991, L.CAVANAGH, (132) 602-310, COR MAT, 2 WITS; 1/6/1993, AYERS ASSOC., SURVEY 632-11, NO NEW INFO

B. Description of corner evidence found and/or method applied in restoring or reestablishing corner:

F-1: FOUND 1/2" SQUARE SHANK IRON IN MON BOX IN CENTERLINE M-55 SPIKE IN POWER POLE S10W 56.4' SE CORNER CHURCH, N50E 125.8' ACCEPTED FOUND CORNER AS BEST EVIDENCE OF POSITION OF ORIGINAL CORNER. THIS CORNER ESTABLISHED IN ROSCOMMON COUNTY REMONUMENTATION PROGRAM. SEE DOSSIER FOR DETAILED REPORT.

C. Description of monument for corner and accessories established to perpetuate locating the position of the corner:

F-1: SET 2" X 21" CAST IRON MONUMENT WITH BRASS ROSCOMMON COUNTY PLATE IN MONUMENT BOX. AZ 359° 45.27' SET SPIKE & TAG IN W FACE UTILITY POLE AZ 40° 102.74' SW CORNER CHURCH AZ 53° 125.83' SE CORNER CHURCH AZ 187° 56.48' FOUND SPIKE IN E. FACE UTILITY POLE

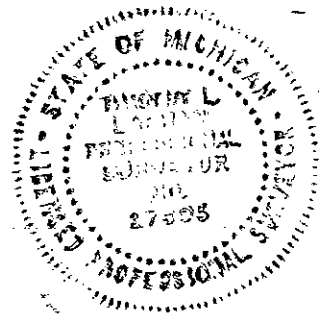

Signed by [Signature] Date 12/20/93

Surveyor's Michigan License No. 27595

Date 11/30/93 Peer Group Approved

LIBER 3 PAGE 45