

LAND CORNER RECORDATION CERTIFICATE
Filing Requirement of Act 74, Mich P.A. 1970

For corners in
Roscommon County

Located in: Corner Code #

1. Public Land Survey T22N R 4W G-7
T R
T R
T R

FILE IN LIBER 3 OF LAND CORNER
STATE OF MICHIGAN
ROSCOMMON COUNTY
RECORDED

22 DEC 98 12:23 P.M.

ROBERT W. SMITH
REGISTER OF DEEDS

Register of Deeds Stamp & File Number

I, Larry L. Cavanagh, in a field survey December, 1998, do hereby certify that under requirements of P.A. 74, Michigan P.A. of 1970, the corner points mentioned in line 1 above was in conformance with regulations and rules therefore as required in the current manual of survey instructions of the United States Department of the Interior, Bureau of Land Management or by a decree of a Court of Law; established, re-established, monumented, recovered, found as expressed below:

A. Description of original monument and accessories and/or subsequent restoration.

SET POST, ARTEMAS CURTIS, 1892 ROBERT L HIGGINS RLS 21570, 1975
LIBER 311, PAGE 189
B. ASH 6 N30°E 10 FD 1/2" BAR
CEDAR 8 S10°W 10 SAME WITNESSES AS ABOVE
M-DOT RECORDS 1940
INDICATE SECTION CORNER
IS SAME LOCATION AS P.I. OF
ROAD CENTERLINE TANGENTS
31.2 EAST OF CENTERLINE
LARRY L CAVANAGH, RLS, 17614, 1976
FD 1/2" BAR
SAME WITNESSES
G.D. HENNING 1948
RE-ESTABLISHED CORNER AT
INTERSECTION OF HWY CENTER-
LINE TANGENTS
NO WITNESSES
DANIEL E. SCHRIFFSEMA, RLS 24617, 1994
LIBER 690, PAGE 324
REC. L311, P189
LARRY L CAVANAGH RLS 17614, 1972
LCRC, LIBER 1, PAGE 75
FD 1/2" BAR
6" MAPLE N45°E 46.95'
3" MAPLE S25°E 40.9'

Grid table with columns A-M and rows 1-12. A dot is marked at the intersection of column G and row 7.

B. Description of corner evidence found and/or method applied in restoring or reestablishing corner:

FOUND 1/2" BAR DRIVEN IN SIDE OF 1' X2' PIPE OVER FORM (PAVEMENT) PIN AT APPARENT INTERSECTION OF CENTERLINE TANGENTS, 32± EAST OF CENTERLINE
THE BEST AVAILABLE EVIDENCE OF THE POSITION OF THE ORIGINAL CORNER.

C. Description of monument for corner and accessories established to perpetuate locating the position of the corner:

SET STANDARD ROSCOMMON COUNTY MONUMENT STAMPED 17614 1998
WIT: NAIL & TAG IN 7" MAPLE S41°E 28.93'
NAIL & TAG IN 8" MAPLE N46°E 47.29'
NAIL & TAG IN 20" MAPLE N77°W 90.23'
CARSONITE POST NORTH 0.85'

ROSCOMMON COUNTY
PEER GROUP APPROVAL
DATE DEC 9, 1998

Marvin E. Myers, P.S.
County Surveyor


SURVEY &
REMONUMENTATION

MAR 01 1999

SECTION

Signed by [Signature]
Surveyor's Michigan License NO. 17614

Date 12/22/98

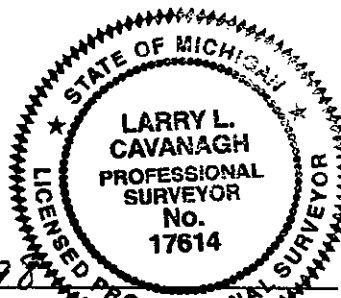

FORM APPROVED BY MICHIGAN STATE BOARD OF LAND SURVEYORS, JAN 28, 1971
REVISED MAY 14, 1975
REVISED JAN., 1983